


Application No. 12759
Permit No. 9075

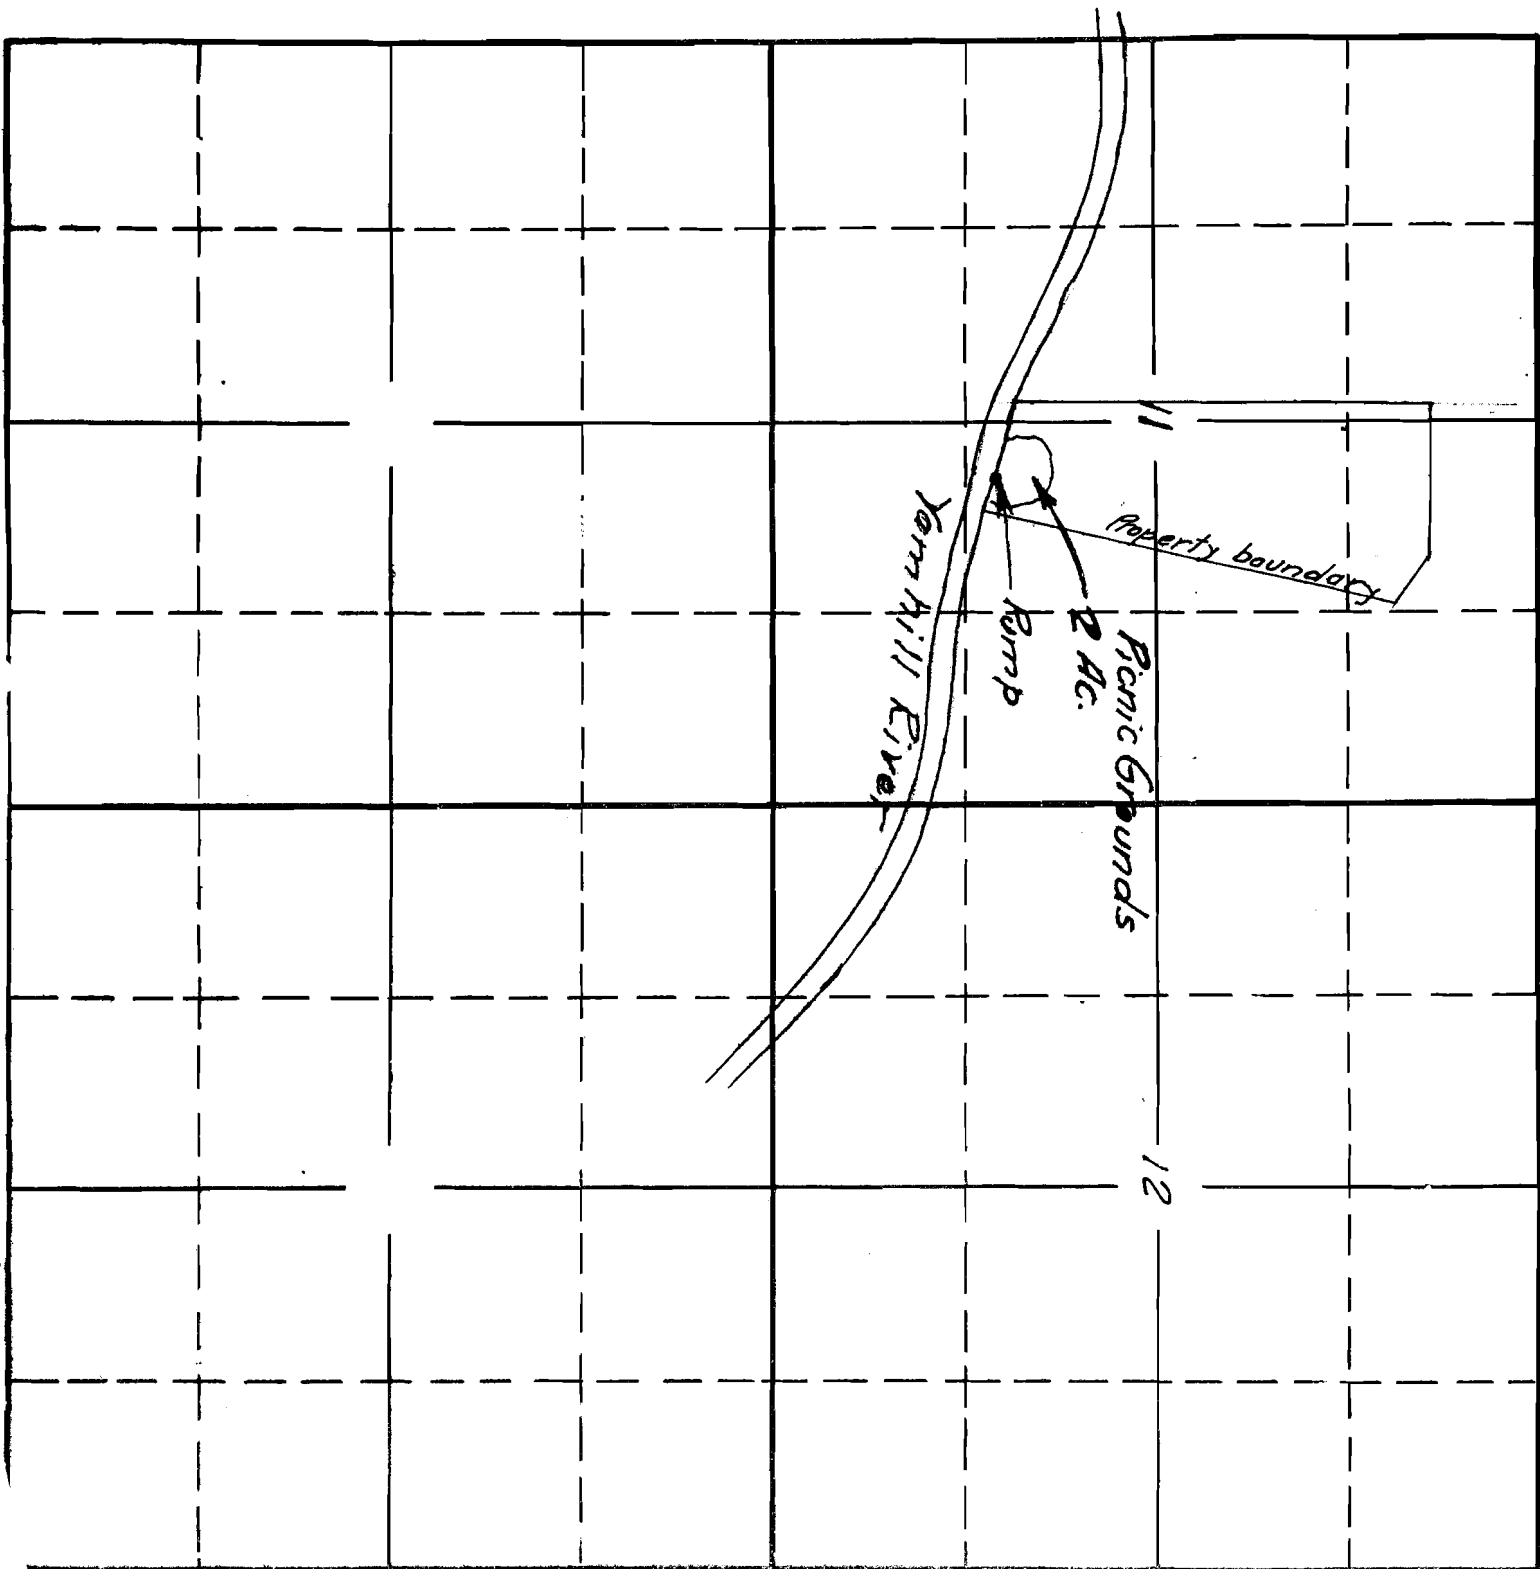

Sec. 11
T_p 4 S.
R. 3 W.