


T.10S., R.27E., W.M.

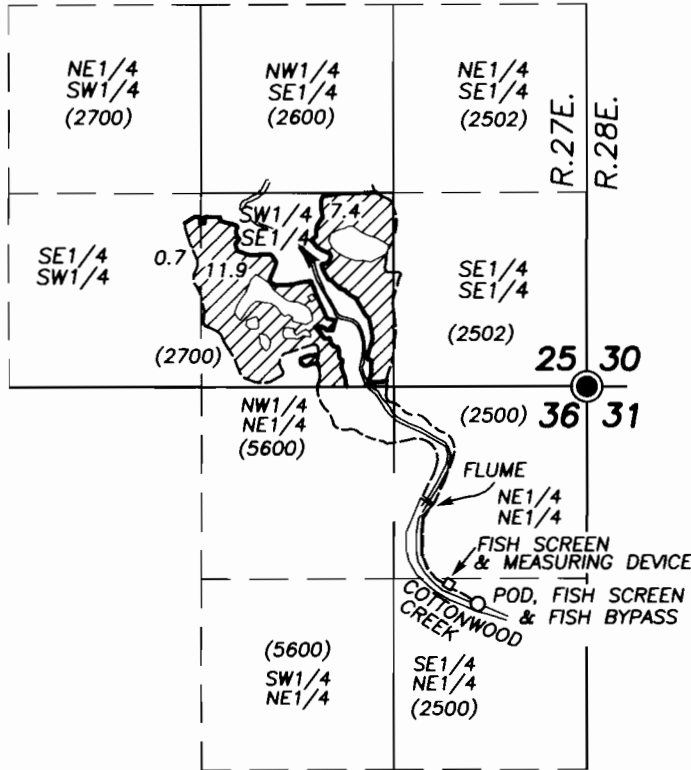

SCALE: 1" = 1320'

FINAL PROOF SURVEY
 UNDER
 APPLICATION NO. T-10997
 SPECIAL ORDER VOL. 81, PG. 863
 FOR
CHANGE OF POINT OF DIVERSION
 IN NAME OF
GARY ENGLE

POD IS 1495 FT. SOUTH & 745 FT. WEST OF NE COR. SEC. 36
 FISH SCREEN AND MEASURING DEVICE ARE 240 FT. NW'LY OF POD

 PLACE OF USE

 FD. GRANT COUNTY SURVEYOR
 BRASS CAP

----- PIPE LINE

() TAX LOT NO.

○ POD, FISH SCREEN AND FISH BYPASS

□ FISH SCREEN AND MEASURING DEVICE

BY

ROBERT D. BAGETT
 217 N. CANYON BLVD.
 JOHN DAY, OREGON
 (541) 575-1251

SEPT. 2, 2011

NOTE: THE PREPARATION OF THIS MAP WAS FOR THE PURPOSE OF IDENTIFYING THE LOCATION OF THE PROPOSED WATER RIGHT AND HAS NO INTENT TO PROVIDE DIMENSIONS OR LOCATION OF PROPERTY OWNERSHIP LINES.

RECEIVED

11-27-2011
 WATER RESOURCES DEPT
 SALEM, OREGON

