

RECEIVED


FEB 05 1999

T.35S.,R.1W.,W.M.

WATER RESOURCES DEPT
SALEM, OREGON



SCALE 1" = 400'

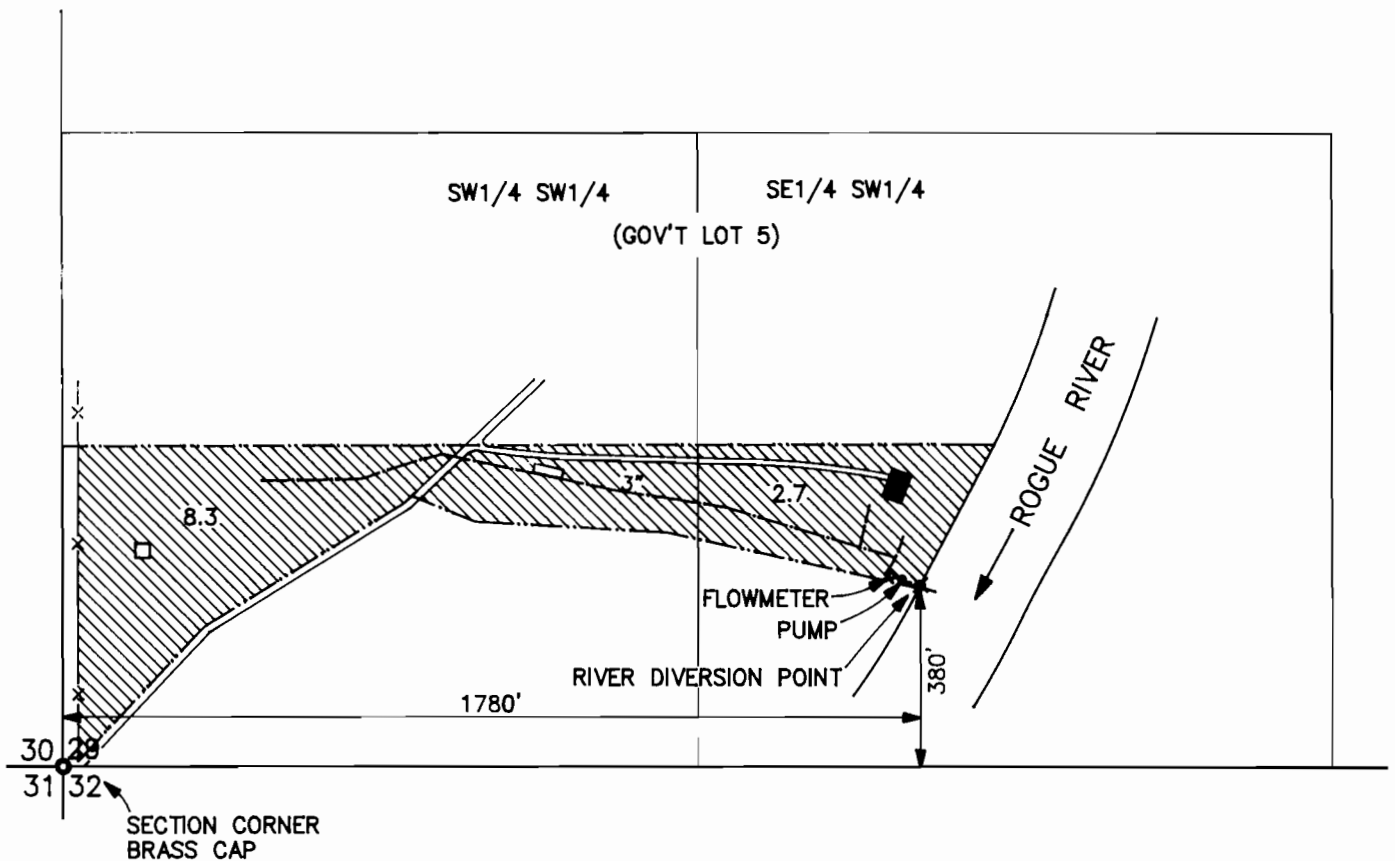

FINAL PROOF MAP

APPLICATION No. T-7555

IN THE NAME OF
CARL J. STOKES

NOTE: MAP PREPARED FOR
WATER RIGHT PURPOSES ONLY,
NOT FOR PROPERTY BOUNDARY
LOCATIONS.

MAP PREPARED JANUARY 22, 1999 BY GARY D. KAISER