


App 12818
Per 9/29

N
N 1/4 cor.

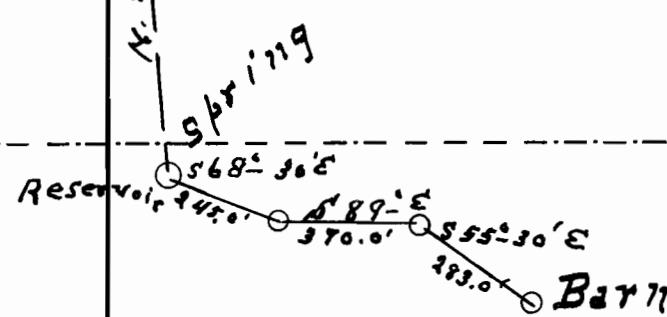

Sec 4.

T 29 S - R 12 W - W. M. Kern
Coos Co. Ore.

I, Edwin H. Kern, of Coosville, Coos County Oregon, do hereby certify
that this map was made from notes taken during an actual survey
made by me on the 20th day of June 1929 and that it correctly
represents the works described in the accompanying application,
together with the location of streams and other ditches in the
immediate vicinity.

E. H. Kern

Registered Professional Engineer
Oregon No 843

Dec. 31st 1919
Scale 1" = 400' ft.
Mag. Var 20' E