

691


**CLAIM OF BENEFICIAL USE**

**MAP T-6854**

Located in Sections 3, 4, 8, 9, 17, 18, and 20,  
Township 14 South, Range 12 East, Willamette Meridian  
Deschutes County, Oregon

**NOTES**




1. This map was prepared for the purpose of identifying the location of water rights only and is not intended to provide legal dimensions or locations of property ownership lines.
2. This map is based on Final Proof Map submitted with the COBU prepared by Anderson Engineering, Sept. 14, 2001.
3. Tax lot lines are based on Deschutes County Assessor Maps dated Feb. 2, 2010.
4. Acres irrigated are identified in each 1/4-1/4 by total acres and by Tax Lot.

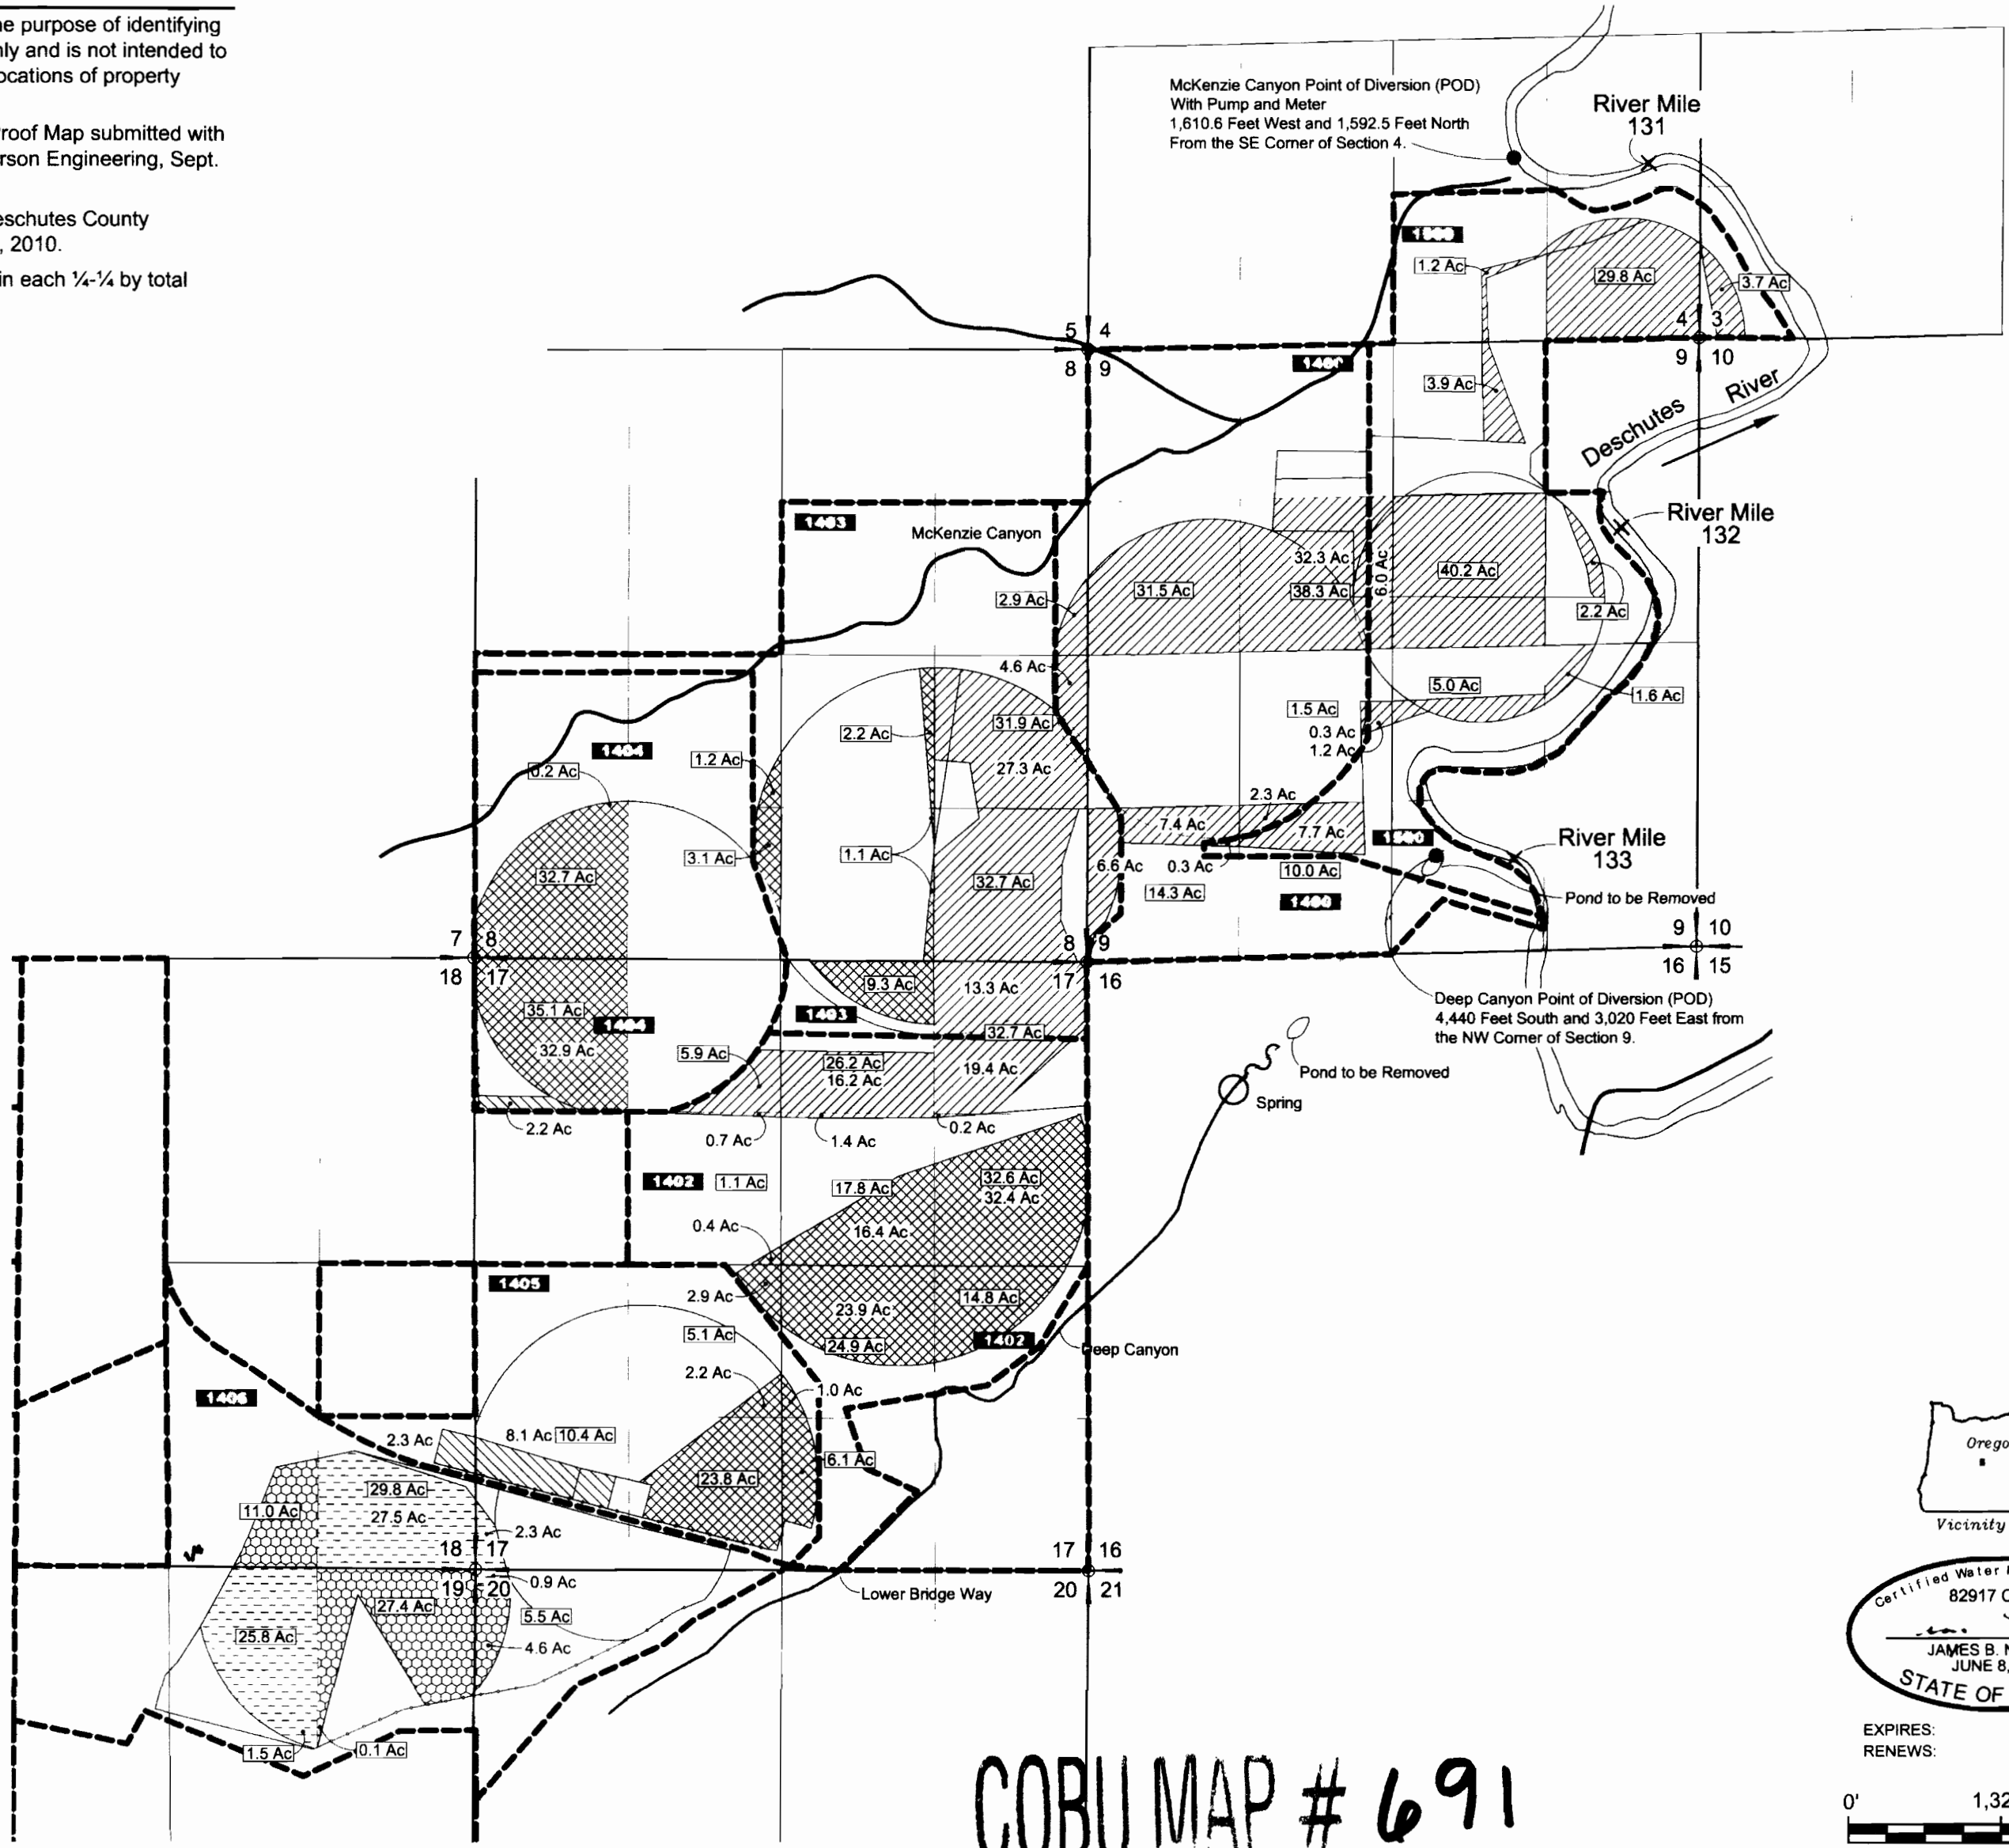

**LEGEND**

- Primary Certificate 44281, Permit 32049 (307.8 Ac Total)
- Supplemental Certificate 44281, Permit 32049 (12.6 Ac Total)
- Supplemental Certificate 44283, Permit 37392 (206.6 Ac Total)
- Primary G-4396 / C-74150 (43.1 Ac Total)
- Primary G-4974 / C-75761 (58.0 Ac Total)
- Tax Lot Boundary Line
- Tax Lot ID Number
- Location of Areas Not Specified in Permit S-37342, Certificate C-44283
- Total Number of Acres Irrigated in 1/4-1/4

JUN 1 2012

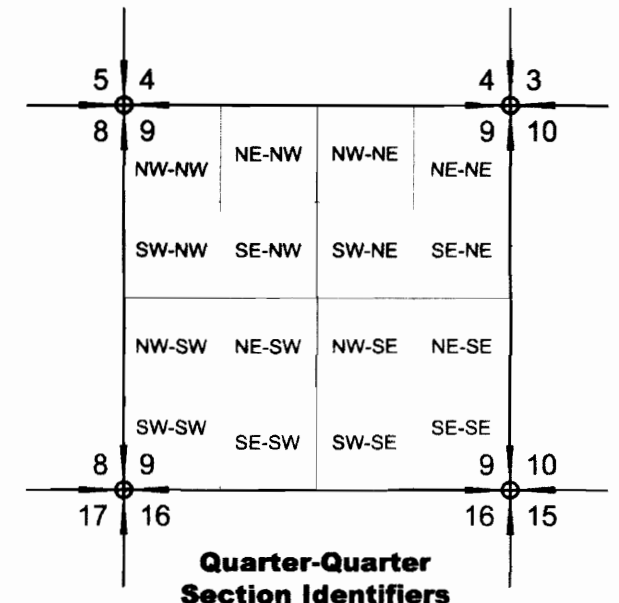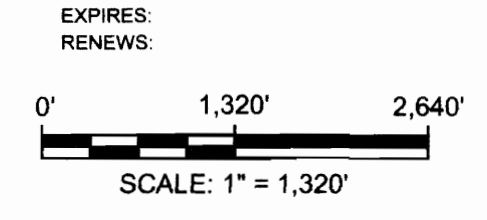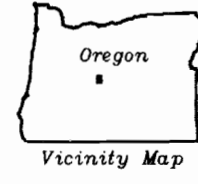

COBU MAP # 691

NO.	DATE	BY	REVISIONS

PATH: G:\0500\556\102\Cad\Water\W556102\_F1\_COBU\_T6854 10:49 05/25/2012 SS

**NEWTON CONSULTANTS INC.**  
Earth, Water and Rock Specialists  
Ph: 541 504-9960 Fax: 541 504-9961



Claim of Beneficial Use Map for T-6854  
Big Falls Ranch Co.  
Deschutes County, Oregon

PROJECT NO: 556-102	DATE: MAY 2012	FIGURE 1
DESIGNED BY: J. Newton	DRAWN BY: S. Schenck	