


CLAIM OF BENEFICIAL USE T-9417

In The Name Of: CLAIR STEVENS

Section 7, Township 38 South, Range 4 West, W.M.
Jackson County, Oregon

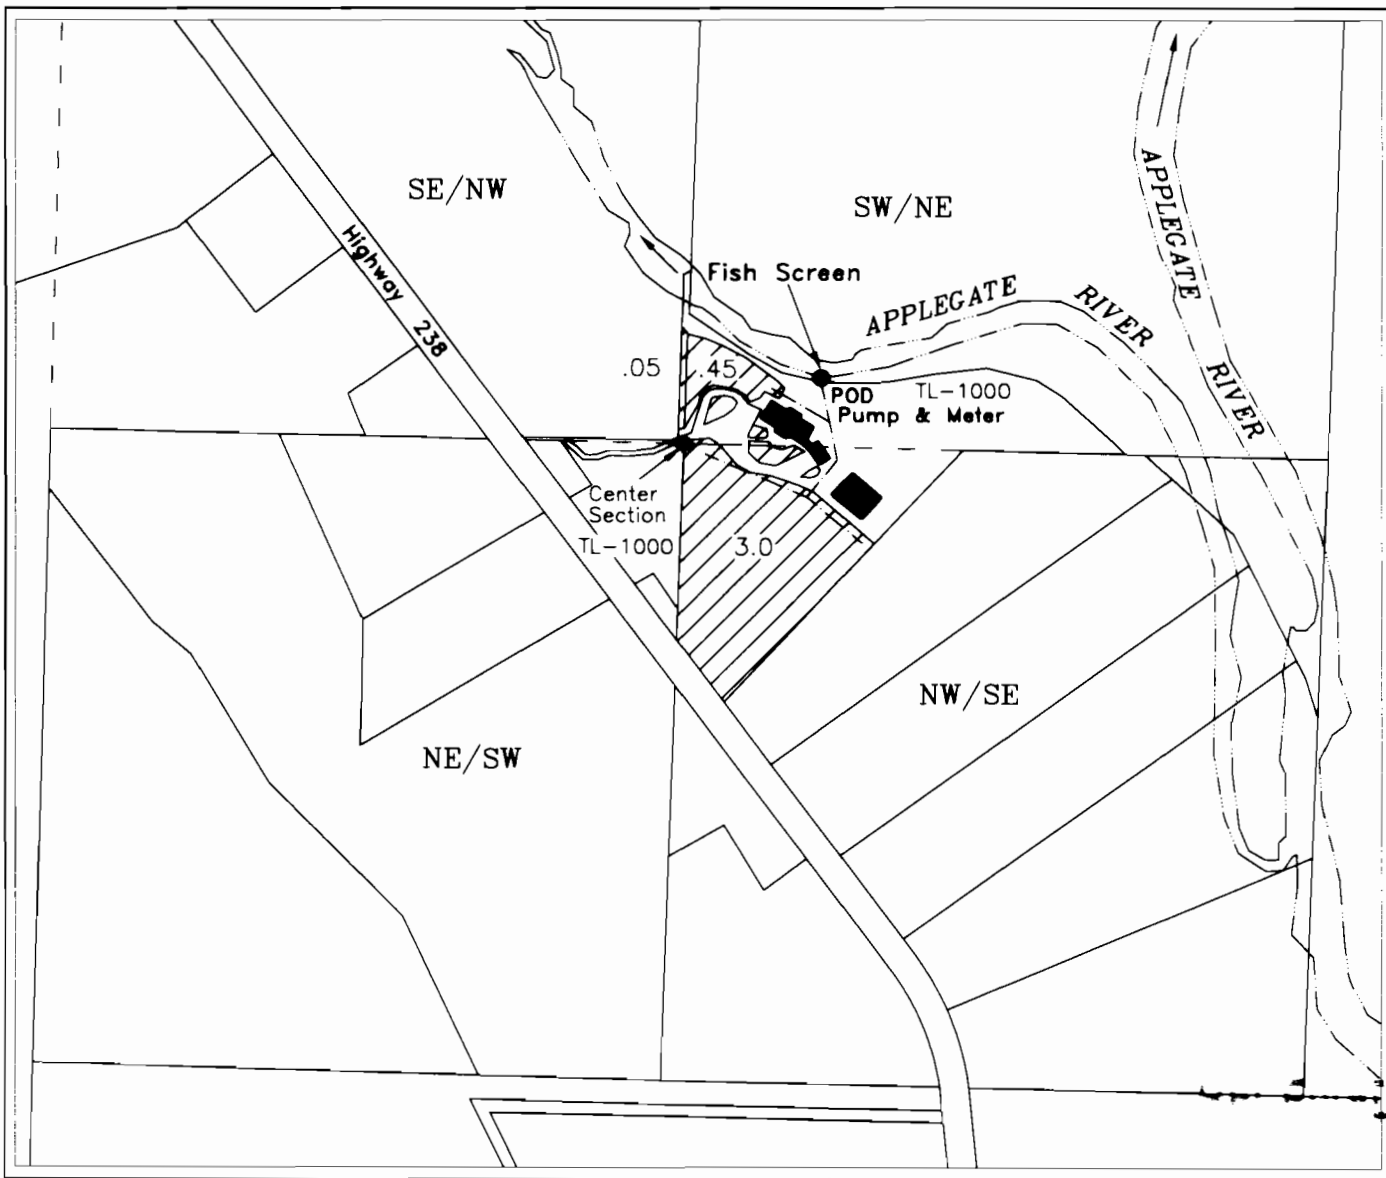

● POD (diversion) SW/NE, 145 feet North & 280 feet East from the Center of Section 7




Area irrigated 3.5 acres



Buildings

Base map Jackson County GIS
over 2005 FSA Aerial Photo for
assumed best fit

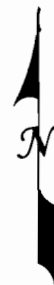

Scale
1 inch = 400 feet



7/7/2010 n.e.d.

This map is not intended to provide legal
dimensions or locations of property ownership lines