




RECEIVED

T. 32 S., R. 5 W., W.M.

SCALE: 1" = 400'

THE PURPOSE OF THIS MAP IS TO IDENTIFY THE LOCATION OF THE
WATER RIGHT. IT IS NOT INTENDED TO PROVIDE INFORMATION RELATIVE
TO THE LOCATION OF PROPERTY OWNERSHIP BOUNDARY LINES.

P.O.D. IS 74 FEET SOUTH AND 94 FEET EAST OF THE
NORTHEAST CORNER OF SECTION 27, T. 32 S., R. 5 W.,
W.M.

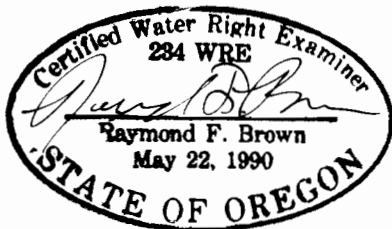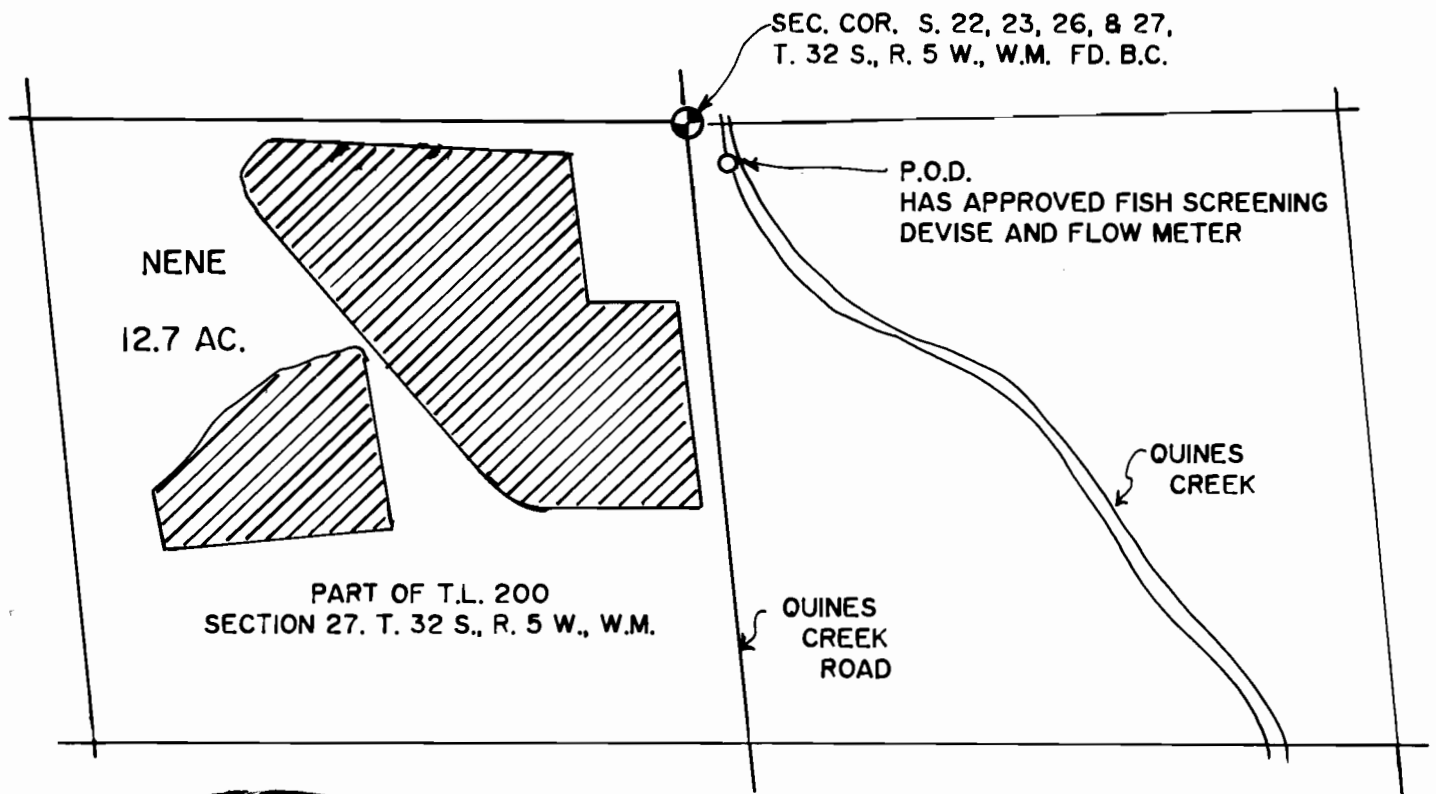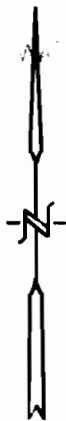

EXP. 12/31/2011

FINAL PROOF SURVEY

UNDER

TRANSFER APPLICATION T - 10447

IN NAME OF

C. CLAY and JUDITH E. DICKERSON

Surveyed SEPT. 23, 2011

by R.F. BROWN