CLAIM OF BENEFICIAL USE MAP FOR:

TRANSFER 9578 AND PERMIT 53996
APPLICATION S-84405

TOWNSHIP 27 SOUTH, RANGE 4 WEST, W.M.

DOUGLAS COUNTY

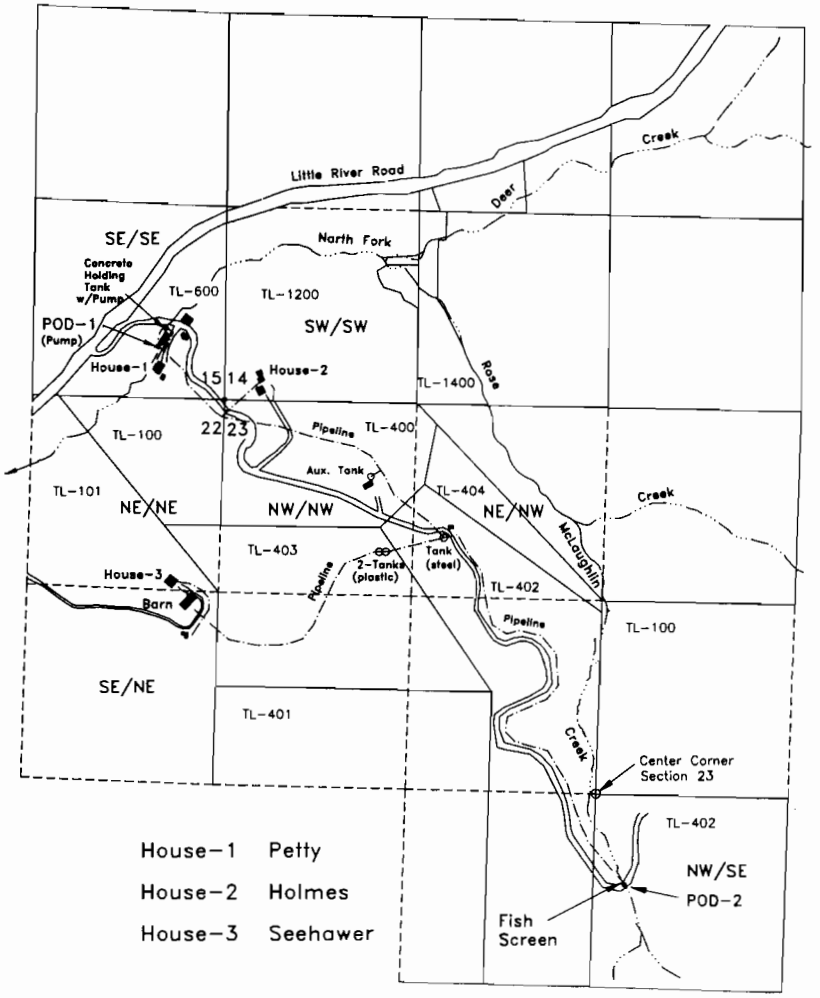

NORTH

Scale

1 inch = 1320 feet

BLM Brass Cap Found

15 14
22 23

POD-1 T-9578 – SE/SE Section 15, 350 ft. north
& 450 ft. west from the SE corner Section 15
3 Domestic Use including 1/2 acre irrigation each

POD-2 PERMIT 53996 – NW/SE, Section 23, 615 ft. south
& 215 ft. east from the center of section 23
3 – Human Consumption

Base map created from Douglas County GIS Data over 2005 FSA aerial photo

This map is not intended to provide legal dimensions or locations of property ownership lines

T-9578 – David and Susan Holmes
Bennirus and Nichole Petty

Permit 53996 – David and Susan Holmes
Bennirus and Nichole Petty
Carl and Judy Seehawer

JORDAN ENGINEERING
460 JORDAN LANE
ROSEBURG, OR 97470
(541) 673-1931

Revised 7/23/2008 n.e.d.
Revised 8/11/2008 KCJ