


FINAL PROOF MAP FOR CHANGE IN POA FOR
LOT 8 REDTAIL MEADOWS SUBDIVISION FOR C.
84484 LOCATED IN SE1/4 SW1/4 OF SECTION
12 AND IN NE1/4 NW1/4 OF SECTION 13,
T.16S., R.16E., W.M., CROOK COUNTY, OREGON
W.O. 12-4261

SCALE

1" = 200'

0 200 400

AUG. 1, 2012

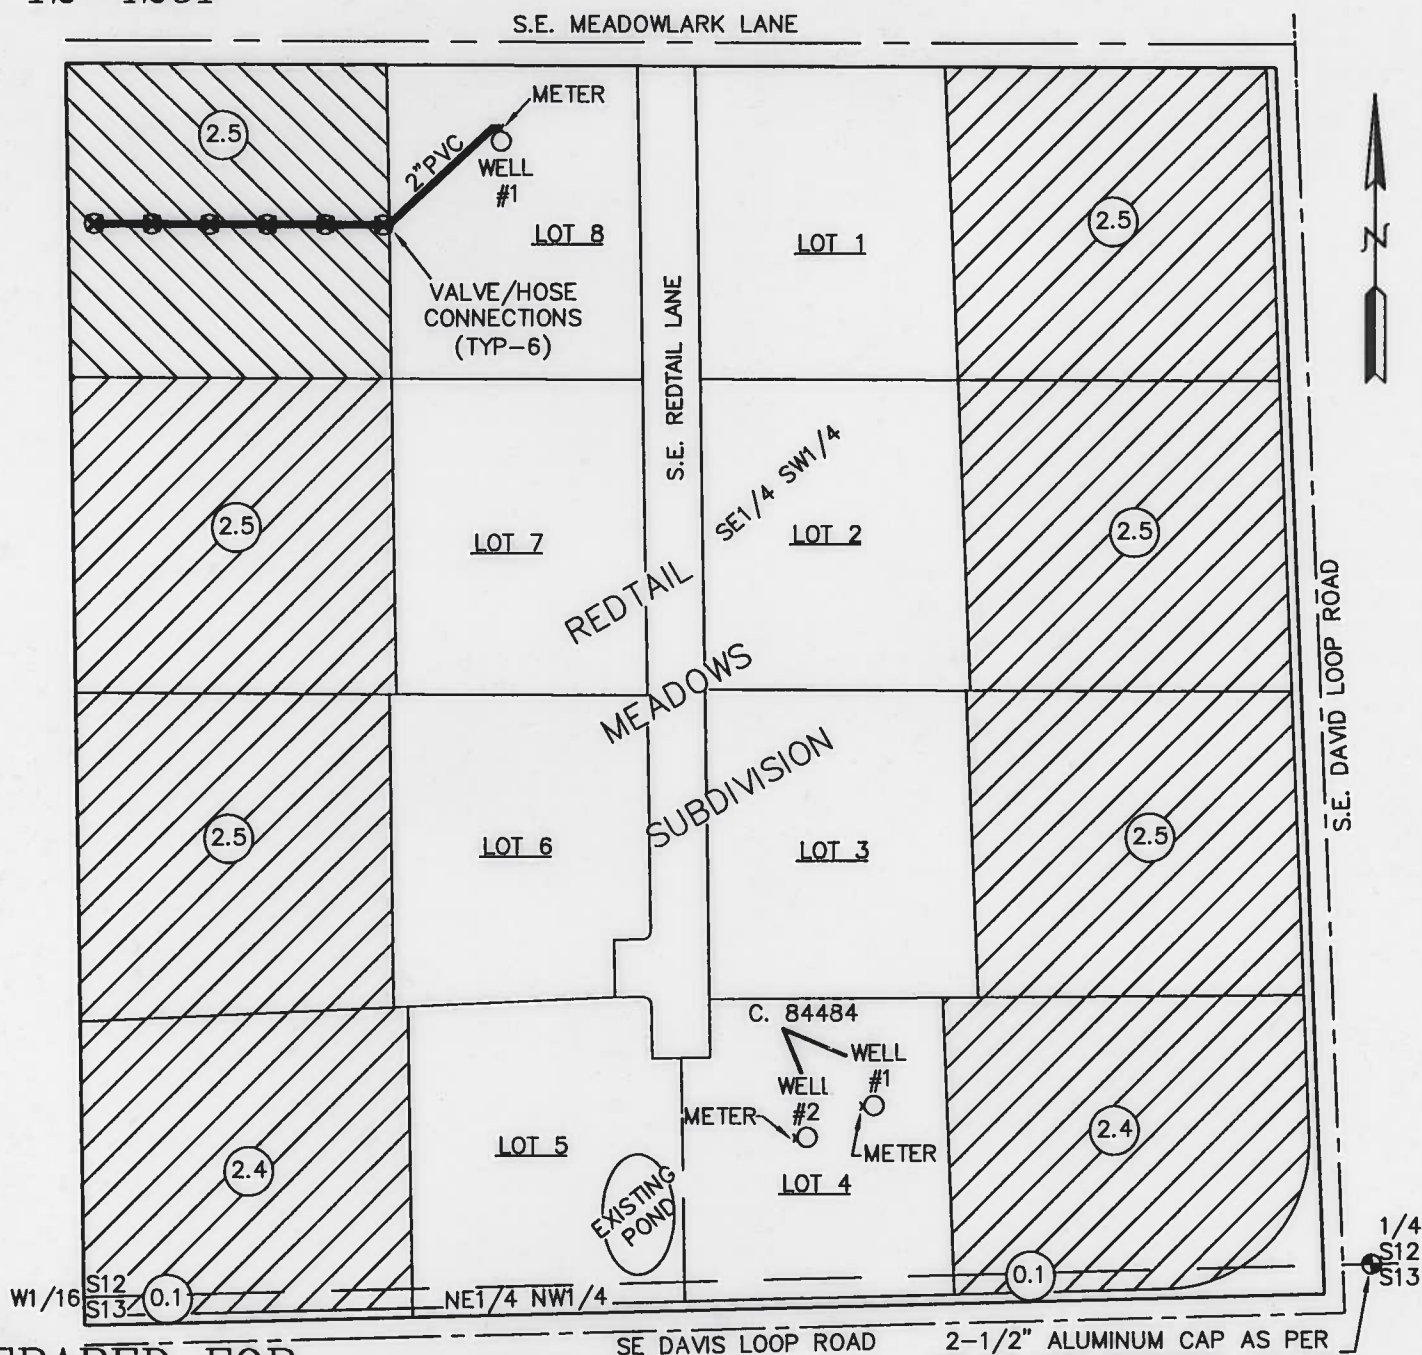

PREPARED FOR PREPARED BY

FRITZ G. DOBIN
DONNA L. DOBIN
P.O. BOX 1137
12175 SE REDTAIL LANE
PRINEVILLE, OR 97754
(541)819-9736

ARMSTRONG SURVEYING
& ENGINEERING, INC
267 NE SECOND ST. STE 100
PRINEVILLE, OR 97754
(541) 447-7791

SE DAVIS LOOP ROAD

2-1/2" ALUMINUM CAP AS PER
CORNER FORM RECORDED JANUARY
23, 1990 BY LS1026

EXISTING WELL LOCATIONS - CERTIFICATE 84484

WELL #1 - LOCATED IN SE1/4 SW1/4 SECTION 12, T.16S.,
R.16E., W.M., 178 FT. NORTH AND 510 FT.
WEST OF THE S1/4 CORNER SECTION 12.

WELL #2 - LOCATED IN SE1/4 SW1/4 SECTION 12, T.16S.,
R.16E., W.M., 147 FT. NORTH AND 581 FT.
WEST OF THE S1/4 CORNER SECTION 12.

CHANGE IN POINT OF APPROPRIATION - T-11074

PERMIT LOCATED IN SE1/4 SW1/4 SECTION 12, T.16S.,
WELL #1 - R.16E., W.M., 1169 FT. NORTH AND 537 FT.
WEST OF THE S1/4 CORNER SECTION 12.

WATER RIGHTS



PRIMARY - C-84484 - NO CHANGE
T.16S., R.16E., W.M. TOTAL - 17.5 AC.

MAP 16-16-12C	PLAT	SECTION 12	SECTION 13
TAX LOT	LOT	SE1/4 SW1/4	NE1/4 NW1/4
700	1	2.5 AC.	-
701	2	2.5 AC.	-
702	3	2.5 AC.	-
703	4	2.4 AC.	0.1 AC.
704	5	2.4 AC.	0.1 AC.
705	6	2.5 AC.	-
706	7	2.5 AC.	-
	TOTAL	17.3 AC.	0.2 AC.



PRIMARY - PERMIT T-11074 - CHANGE POA
T.16S., R.16E., W.M. TOTAL - 2.5 AC.

MAP 16-16-12C	PLAT	SECTION 12	SECTION 13
TAX LOT	LOT	SE1/4 SW1/4	NE1/4 NW1/4
707	8	2.5 AC.	-

RECEIVED BY OWRD

AUG 15 2012

SALEM, OR

MAP NOTE

THE PREPARATION OF THIS MAP IS FOR THE PURPOSE OF IDENTIFYING
THE LOCATION OF THE WATER RIGHT ONLY AND HAS NO INTENT TO
PROVIDE DIMENSIONS OR LOCATIONS OF PROPERTY OWNERSHIP LINES.

Renews December 31, 2013

SHEET 1 OF 1

DRG. NO. 10-3985.DWG

W.O. 12-4261