

TOWNSHIP 38 SOUTH, RANGE 4 WEST, W.M.
SECTION 21
JACKSON COUNTY, OREGON
FOR
MARSHA J. HORSLEY
17911 North Applegate Road – Grants Pass, Or. 97527




LEGEND
October 10, 2001

Scale 1" = 400'

- Survey Monument
- Denotes Building

FINAL PROOF SURVEY
TRANSFER T- 8357

Point of Diversion, 480.32 feet North and
829.92 feet West from section corner to
Sections 16, 17, 20 and 21.

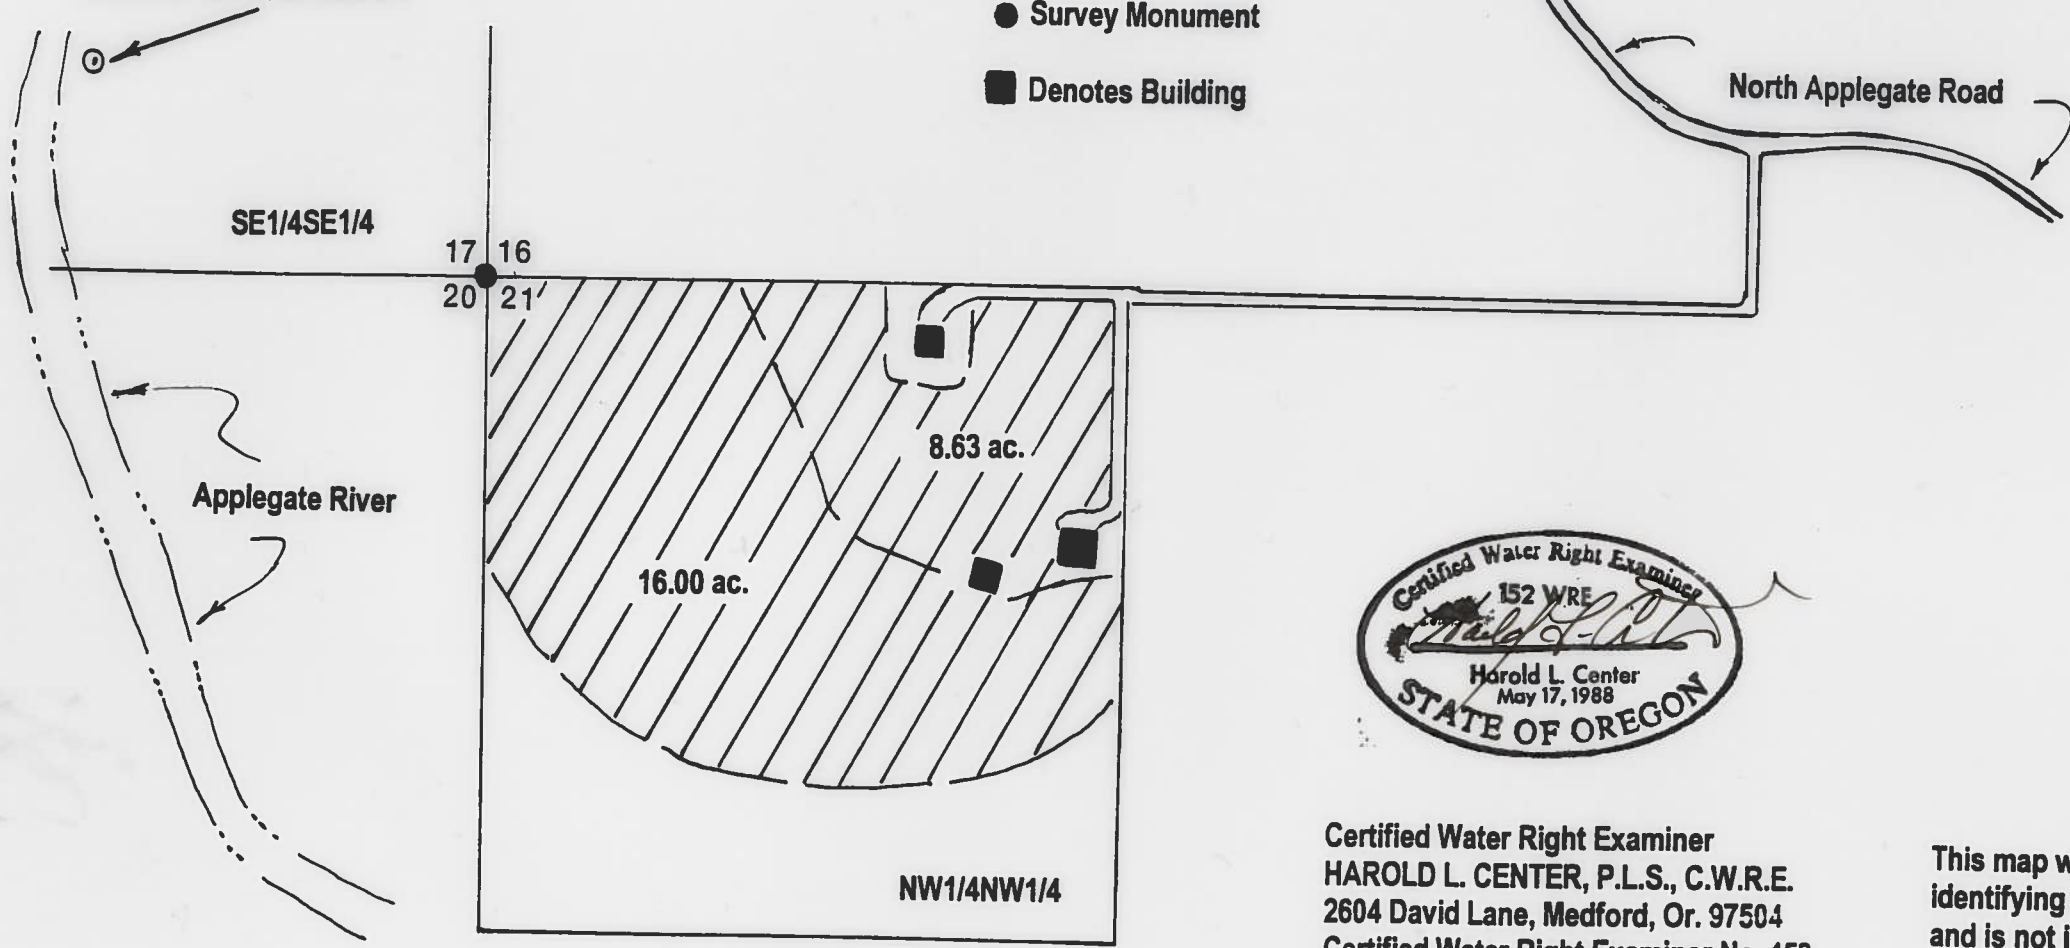

RECEIVED
OCT 22 2001
WATER RESOURCES DEPT.
SALEM, OREGON



Certified Water Right Examiner
HAROLD L. CENTER, P.L.S., C.W.R.E.
2604 David Lane, Medford, Or. 97504
Certified Water Right Examiner No. 153
Certificate renewal date: 12/31/01

This map was prepared for the purpose of
identifying the location of a water right only
and is not intended to provide legal dimensions
or locations of ownership lines.