

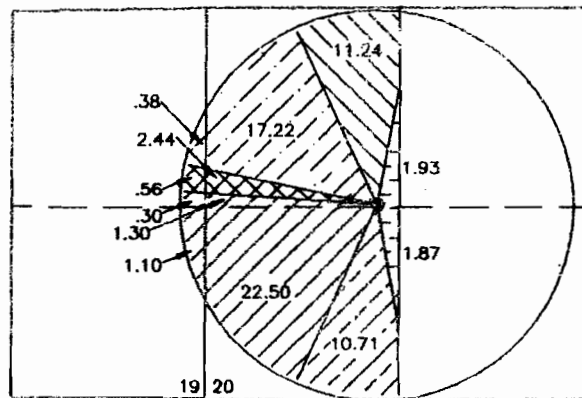


FINAL PROOF MAP


T.25S. R.14E., W.M.
SE 1/4 SECTION 19 & SW 1/4 SECTION 20
LAKE COUNTY, OREGON
TAX LOT 1003
TRANSFER #'S 7382, 7384, 7385 & 7386
SCOTT & JANA KITTREDGE

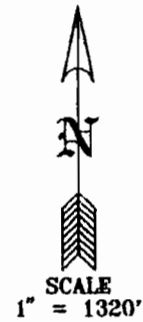


WELL IS LOCATED N40°58'21"E
1761.59' FROM THE SW SECTION
CORNER SECTION 20

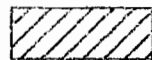

T-7382 (P G-7646) .30 ac, 1.30 ac,
1.10 ac & 22.50 ac

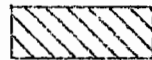


T-7386 (P G-6295) 11.24 ac

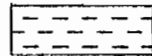


T-7386 (P G-7129) 1.93 ac & 1.87 ac




T-7384 (P G-9062) 2.44 ac & .56 ac

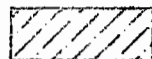

T-7385 (P G-9509) 17.22 ac & .38 ac

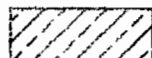

T-7386 (P U-713) 10.71 ac

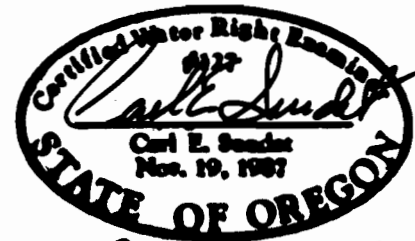

Renews 6/30/02

APPROVED

RECEIVED
FEB 10 2001

Survey by: Sundet & Associates
P.O. Box 1228
Lakeview, OR 97630
541-947-3293
August 2000 Dr: kitt2

This map is for the purpose of identifying the location
of the water right only and is not intended to provide
legal dimensions or property ownership lines.