


CLAIM OF BENEFICIAL USE
FOR: DORMAN AND MICKI TREADWAY
BY: DUANE W. KIRBY
DATE: 10/01/08
T25S, R5W W.M., SEC 9
T-10067
TAX LOT 204
FISH SCREEN IS AT POD
SCALE: 1" = 1320'

RECEIVED
2008

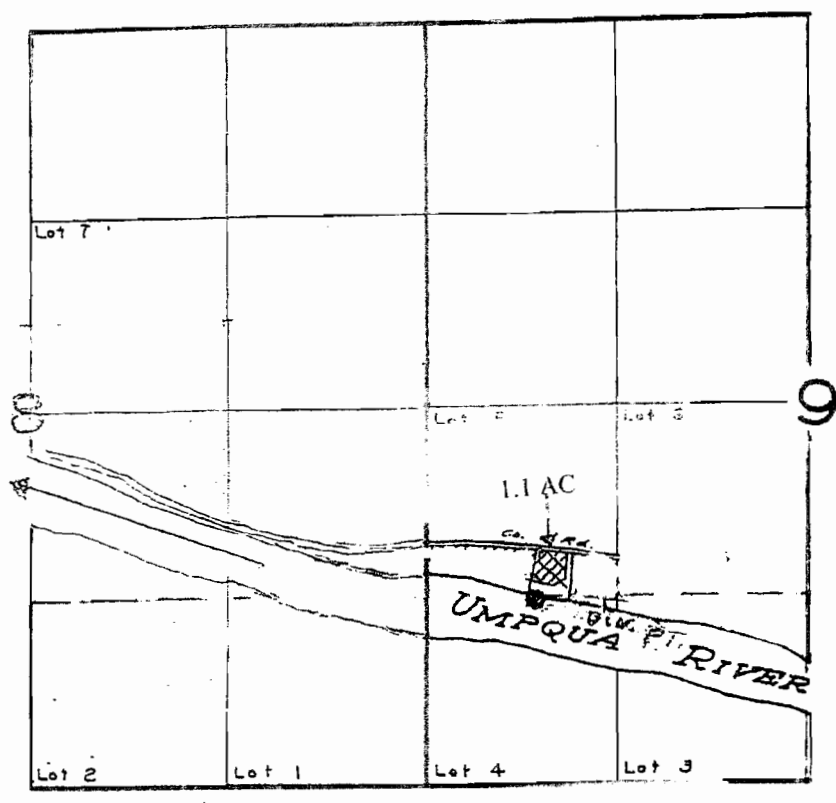

PT OF DIV. S29°03' 21" E 1413.96' FROM THE EAST ¼ CORNER OF SEC 8

THE PURPOSE OF THIS MAP IS TO IDENTIFY THE LOCATION OF THE WATER RIGHT. IT IS NOT INTENDED TO PROVIDE INFORMATION RELATIVE TO THE LOCATION OF PROPERTY OWNERSHIP BOUNDARY LINES.

