

CLAIM OF BENEFICIAL USE MAP FOR T-9482


T. 35 S., R. 7 W., W. M., JOSEPHINE COUNTY
Portion of Section 14

April 16, 2005

N

1" = 400'

RECEIVED
JUN 08 2005
WATER RESOURCES DEPT
SALEM, OREGON

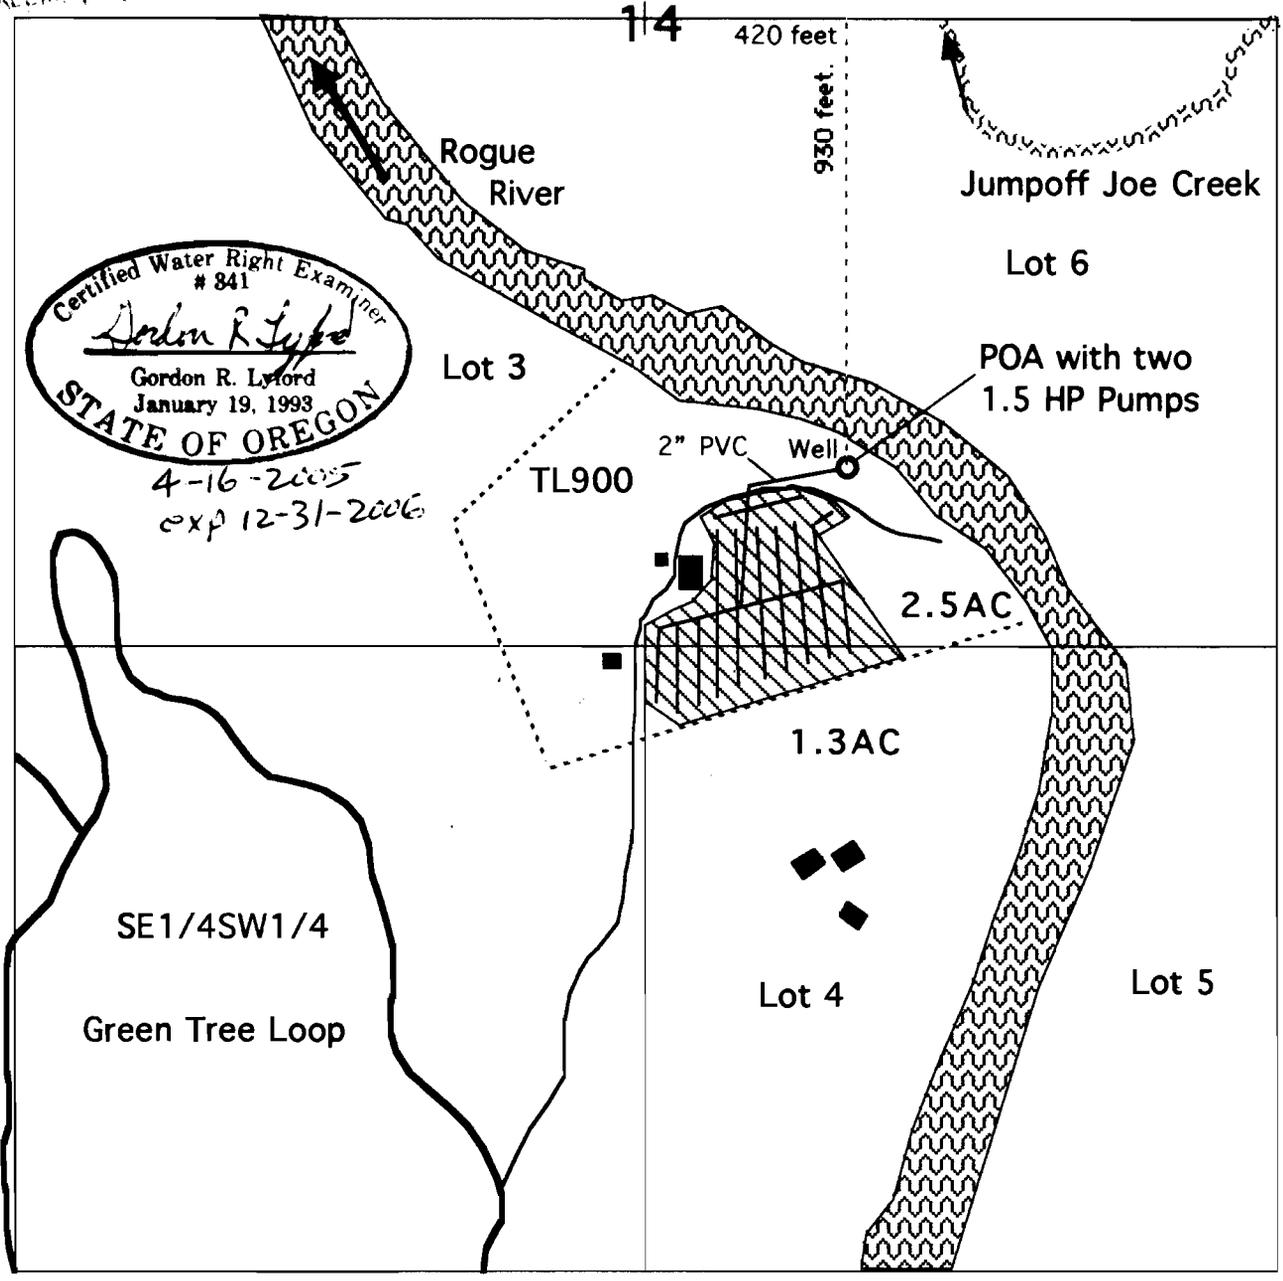

Certified Water Right Examiner
841
Gordon R. Lyford
Gordon R. Lyford
January 19, 1993
STATE OF OREGON
4-16-2005
exp 12-31-2006

 3.8 acres of irrigation rights with a priority of April 12, 1935 originally from Application S-15785, Permit S-11644, and Certificate 12026 (canceled June 7, 2004).

This map was drawn by Gordon R. Lyford for Robert Hamlyn to support the Claim of Beneficial Use for T-9482 to change the POD to a POA on the OK Corral property.

This map was prepared for the purposes of identifying the location of water rights only and is not intended to provide legal dimensions or the location of property ownership lines.