



Claim of Beneficial Use



Point of Diversion Transfer T-10986

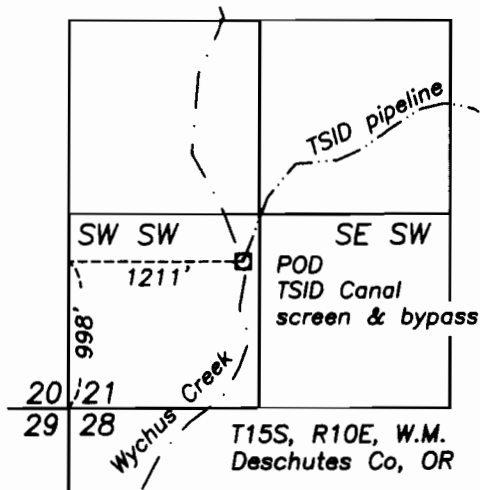

POD for T-10986: 998' North and 1211' East from SW Corner Sec. 21

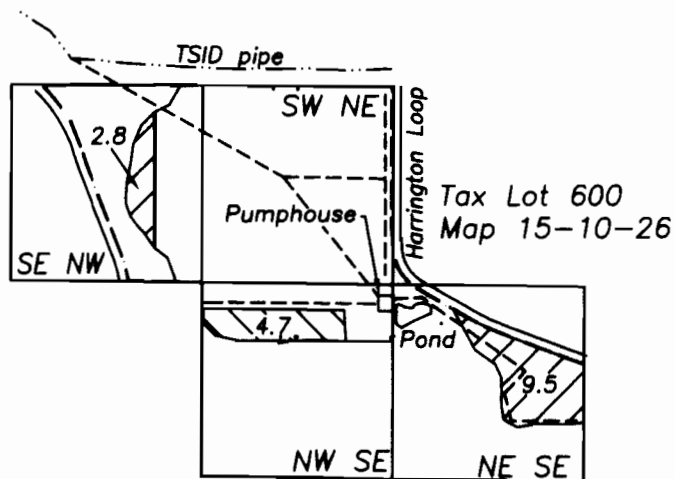

Section 26
T15S, R10E, W.M.
Deschutes Co., OR

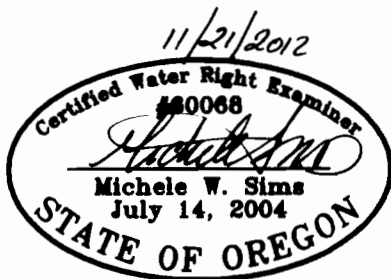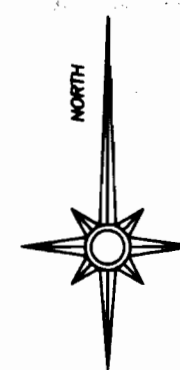

Renewal date: 6/30/2014

Legend

- Water beneficially applied under transfer T-10986, priority date November 1904.
- Property line
- Mainline
- Three Sisters Irr. Dist. Pipeline

1320 0 1320 2640 3960



GRAPHIC SCALE - FEET

THIS MAP IS FOR THE PURPOSE OF IDENTIFYING THE LOCATION OF THE WATER RIGHT. IT IS NOT INTENDED TO PROVIDE LEGAL DIMENSIONS OR LOCATIONS OF PROPERTY OWNERSHIP LINES.