


T13S, R24E, W.M.
Wheeler County
Claim of Beneficial Use Map T-10996
Canceled Certificates 25918, 25924, 37255, 83217 & 83219


RECEIVED

DEC 11 2012

WATER RESOURCES DEPT
SALEM, OREGON

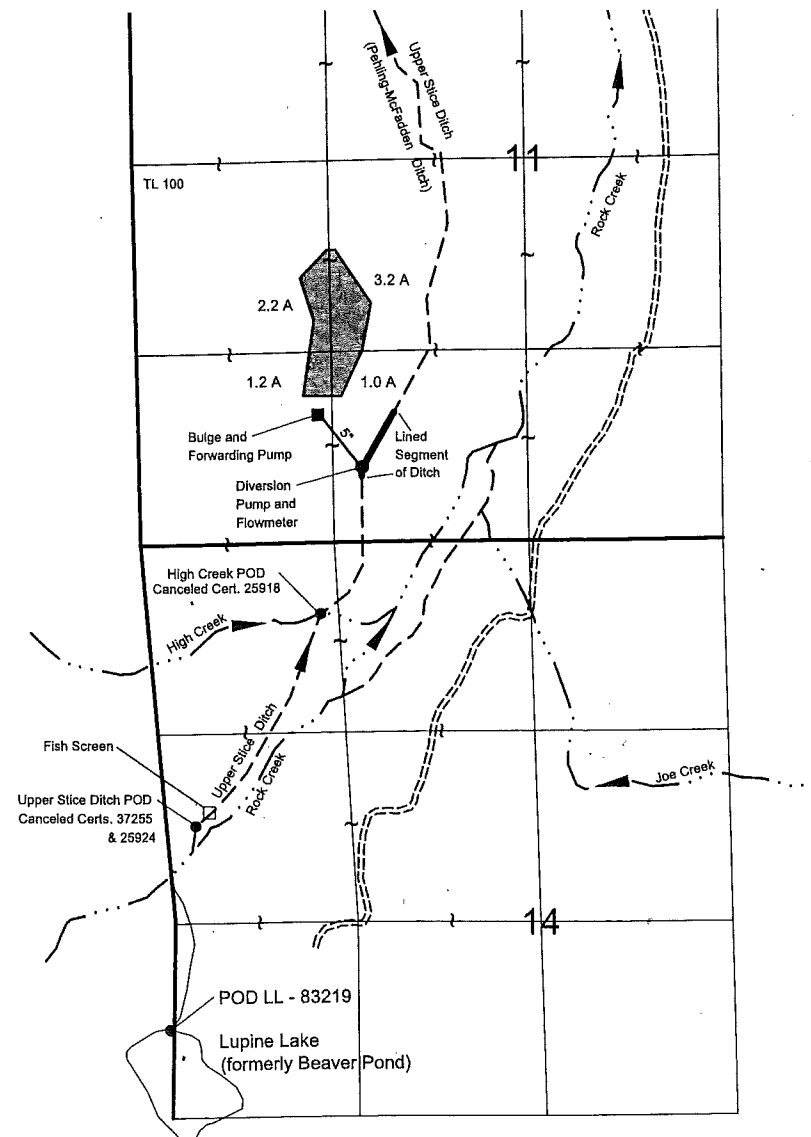




Primary Rights

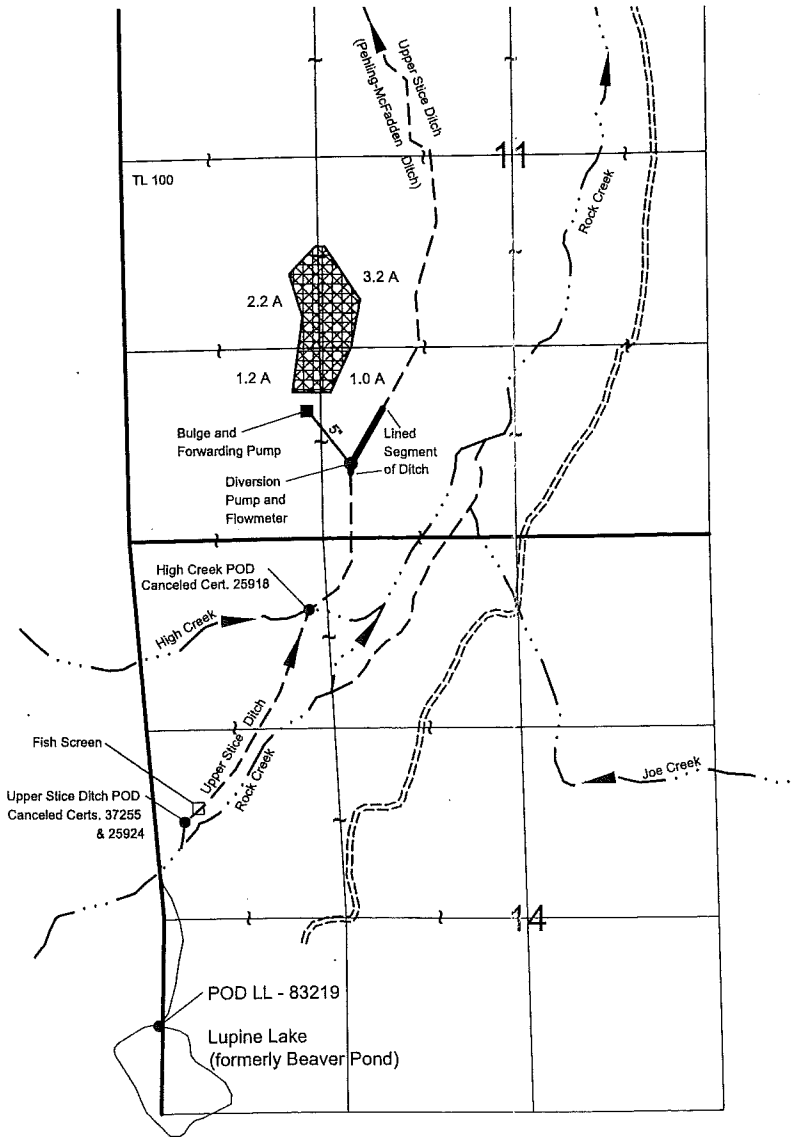


Supplemental Rights

EXPLANATION:

- Primary Irrigation
Canceled Certificate 25918
Priority: 1887
(7.6 Acres)
- Supplemental Irrigation
Canceled Certificate 25924
Priority: 1899
(7.6 Acres)
- Supplemental Irrigation
Canceled Certificate 37255
Priority: 1854
(7.6 Acres)
- Supplemental Irrigation
Canceled Certificate 83217
Priority: 1984
(7.6 Acres)
- Supplemental Irrigation
Canceled Certificate 83219
Priority: 1986
(7.6 Acres)

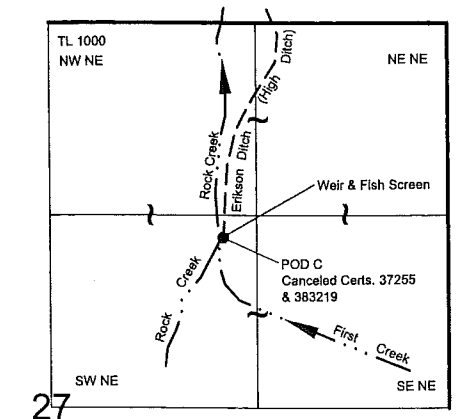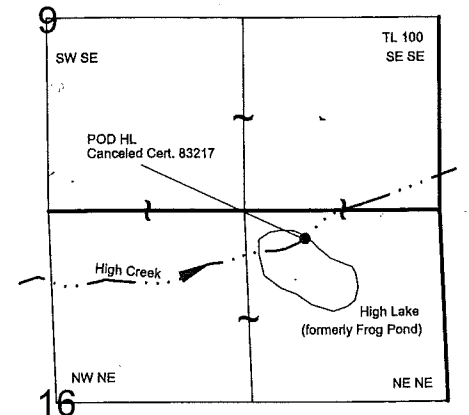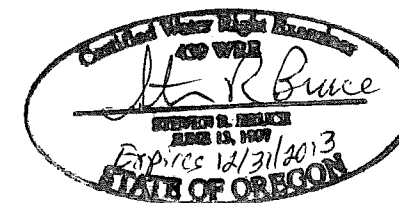

October 31, 2012
THIS MAP IS NOT INTENDED TO
PROVIDE LEGAL DIMENSIONS OR
LOCATIONS OF PROPERTY
OWNERSHIP LINES.

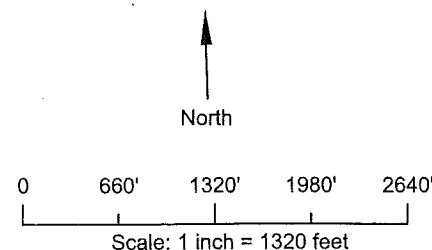

High Creek POD located 480 feet south and 1,220 feet east from NW corner of Section 14.
Upper Slice Ditch POD located 1,960 feet south and 2,300 feet west from N 1/4 corner of Section 14.
POD C located 1,460 feet south and 1,290 feet east from N 1/4 of Section 27 (formerly "Highline" - see inset map).
POD LL located 3,380 feet south and 2,280 feet west from N 1/4 corner of Section 14.
POD HL located 210 feet south and 940 feet west from NE corner of Section 16 (formerly "Frog Pond" - see inset map).

Figure 1

SKOOKUM
WATER ASSOCIATES INC
P.O. Box 80174
Portland, OR 97280
(503) 319-8926

COBU MAP # 735