


T.4S. R.1W. Section 8

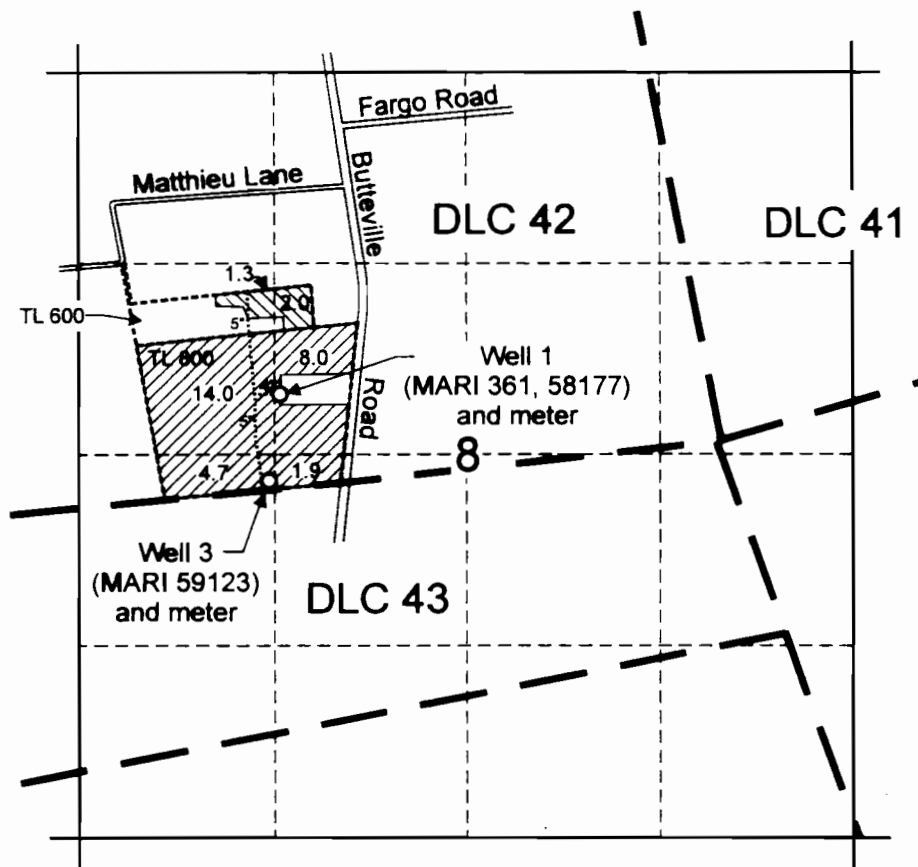

Well 1 (MARI 361, 58177) is located 330 feet north and 3,019.5 feet west from the SE corner of DLC 42.
 Well 3 (MARI 59123) is located 280 feet south and 3,090 feet west from the SE corner of DLC 42.

 Authorized Place of Use (28.6 Acres) for Application G-1229, Permit G-968, Certificate 30510.

 Authorized Place of Use (3.3 Acres) for Application G-2371, Permit G-2184, Certificate 67113.

----- Tax Lot Boundary

..... Mainline


RECEIVED

OCT 01 2004

Scale: 1" = 1,320'



0 1,320 Feet

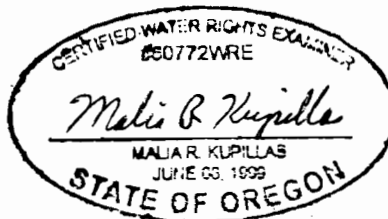

EXPIRATION DATE: 6/30/09

This map was prepared for the purpose of identifying the location of a water right only and is not intended to provide legal dimensions or location of property ownership lines.



Pacific Hydro-Geology Inc.

Claim of Beneficial Use Map
for T-9855

Richard Malone
T.4S. R.1W. Section 8B, Tax Lots 600 and 800

12/2004