


FINAL PROOF MAP

TO ADD A RESERVOIR
FOR PERMIT R-13649

TOWNSHIP 3 NORTH, RANGE 4 WEST, SECTION 17, W.M.
TAX LOT: 5700

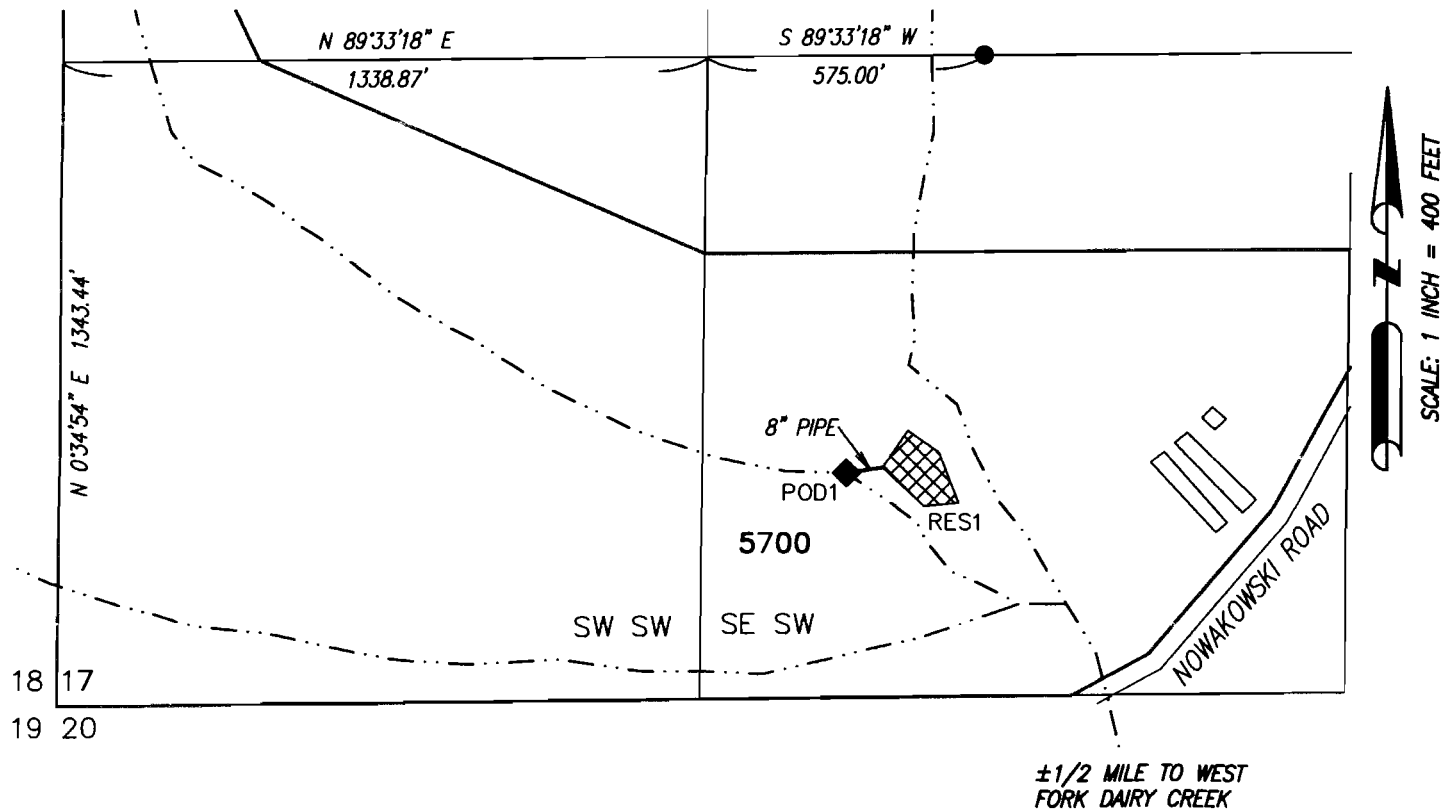

◆ POD1 (OFF-STREAM)

PIPE DIVERSION IN THE SE1/4 OF THE SW1/4 OF SECTION 17
LOCATED 487 FEET NORTH AND 1641 FEET EAST FROM THE SW
1/4 CORNER OF SECTION 17, TOWNSHIP 3 NORTH, RANGE 4
WEST, W.M., WASHINGTON COUNTY, OREGON

RECEIVED BY OWRD

MAY 01 2013

SALEM, OR

● FOUND SURVEY MONUMENT

▤ 1.5 ACRE-FT RESERVOIR, AS SHOWN

--- UNNAMED STREAM

THIS MAP IS FOR THE PURPOSE OF LOCATING A WATER
RIGHT ONLY AND HAS NO INTENT TO PROVIDE LEGAL
DIMENSIONS OR THE LOCATION OF PROPERTY LINES

PREPARED FOR:

THOMAS TIBBS
6070 SW 190TH
ALOHA, OR 97007

PREPARED BY:



ALL POINTS ENGINEERING AND SURVEYING, INC.
P.O. BOX 767 (CRR) TERREBONNE, OR 97760
(541) 548-5833
www.APEandS.com