

34 35

35

SOUTH TOWNSHIP ROAD

3 2

2

S 47°52'40" E 1799.3'

NW 1/4 NW 1/4

NE 1/4 NW 1/4

16.00 ACRES
IRRIGATION.
AGRICULTURAL
PRODUCE

6" DIAMETER
DELIVERY PIPE

WELL

RECEIVED

NOV 23 2005


WATER RESOURCES DEPT
SALEM, OREGON



SCALE: 1" = 400'


SECTION 2, T.4S., R.1E., W.M.
CLACKAMAS COUNTY, OREGON

This drawing is an exhibit for a Ground Water Transfer Proof Survey. It is not a Land Survey. Property lines and/or other lines of occupation shown hereon are not represented by the undersigned to meet accuracy standards of Land Surveys.

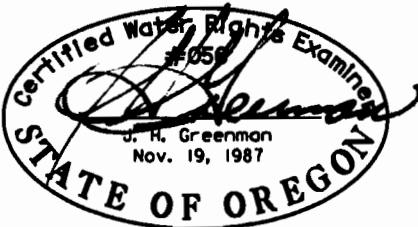

TRANSFER No. T-9707

CERTIFICATE No. 76453

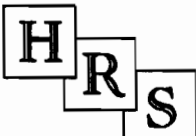

**HANER, ROSS &
SPORSEEN, INC.**

15 S.E. 82ND DRIVE
GLADSTONE, OREGON 97027

**KEVIN ANN SODERBERG
GROUND WATER TRANSFER
PROOF SURVEY**

REV. 0: 2005/11/17

1225