

FINAL PROOF MAP T39S R8W SEC. 16

TRANSFER OF POINT OF DIVERSION AND PLACE OF USE
OCTOBER 5, 2004

T-8521

APPLICANT:
Illinois Valley Golf Association
25320 Redwood Highway
Cave Junction, Oregon 97523

NOTE: Water right from Springs and George Creek, a tributary of E. Fork of Illinois River, for 1.1 acres, confirmed by decree of record in Volume 13, Page 70 of records (priority date of 1884) is not part of this transfer.

SURVEY BY:



**TIMBERLINE
LAND SURVEYING
INCORPORATED**
KERRY K. BRADSHAW L.S. 2271
P.O. BOX 3084
CENTRAL POINT OREGON 97502
(541)864-7510 CELL 944-6692


Certified Water Right Examiner
233
Kerry K. Bradshaw
May, 22, 1990
STATE OF OREGON

NOTE:
All acres subject o change in point of diversion

(B) Areas confirmed by the right perfected under Permit No. 44911 (priority date of March 15, 1979) For 12.0 acres....proposed certificate of water right issued..

(A) Areas confirmed by court decree of record at Salem in the Order Record of the WATER RESOURCES DIRECTOR, in Volume 13, at Page70. (priority date of May 1887) For 20.6 acres. proposed certificate of water right issued....

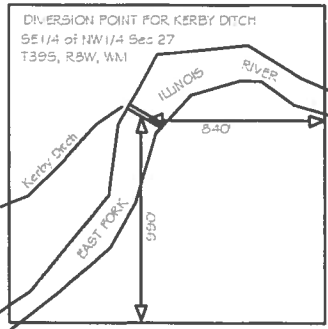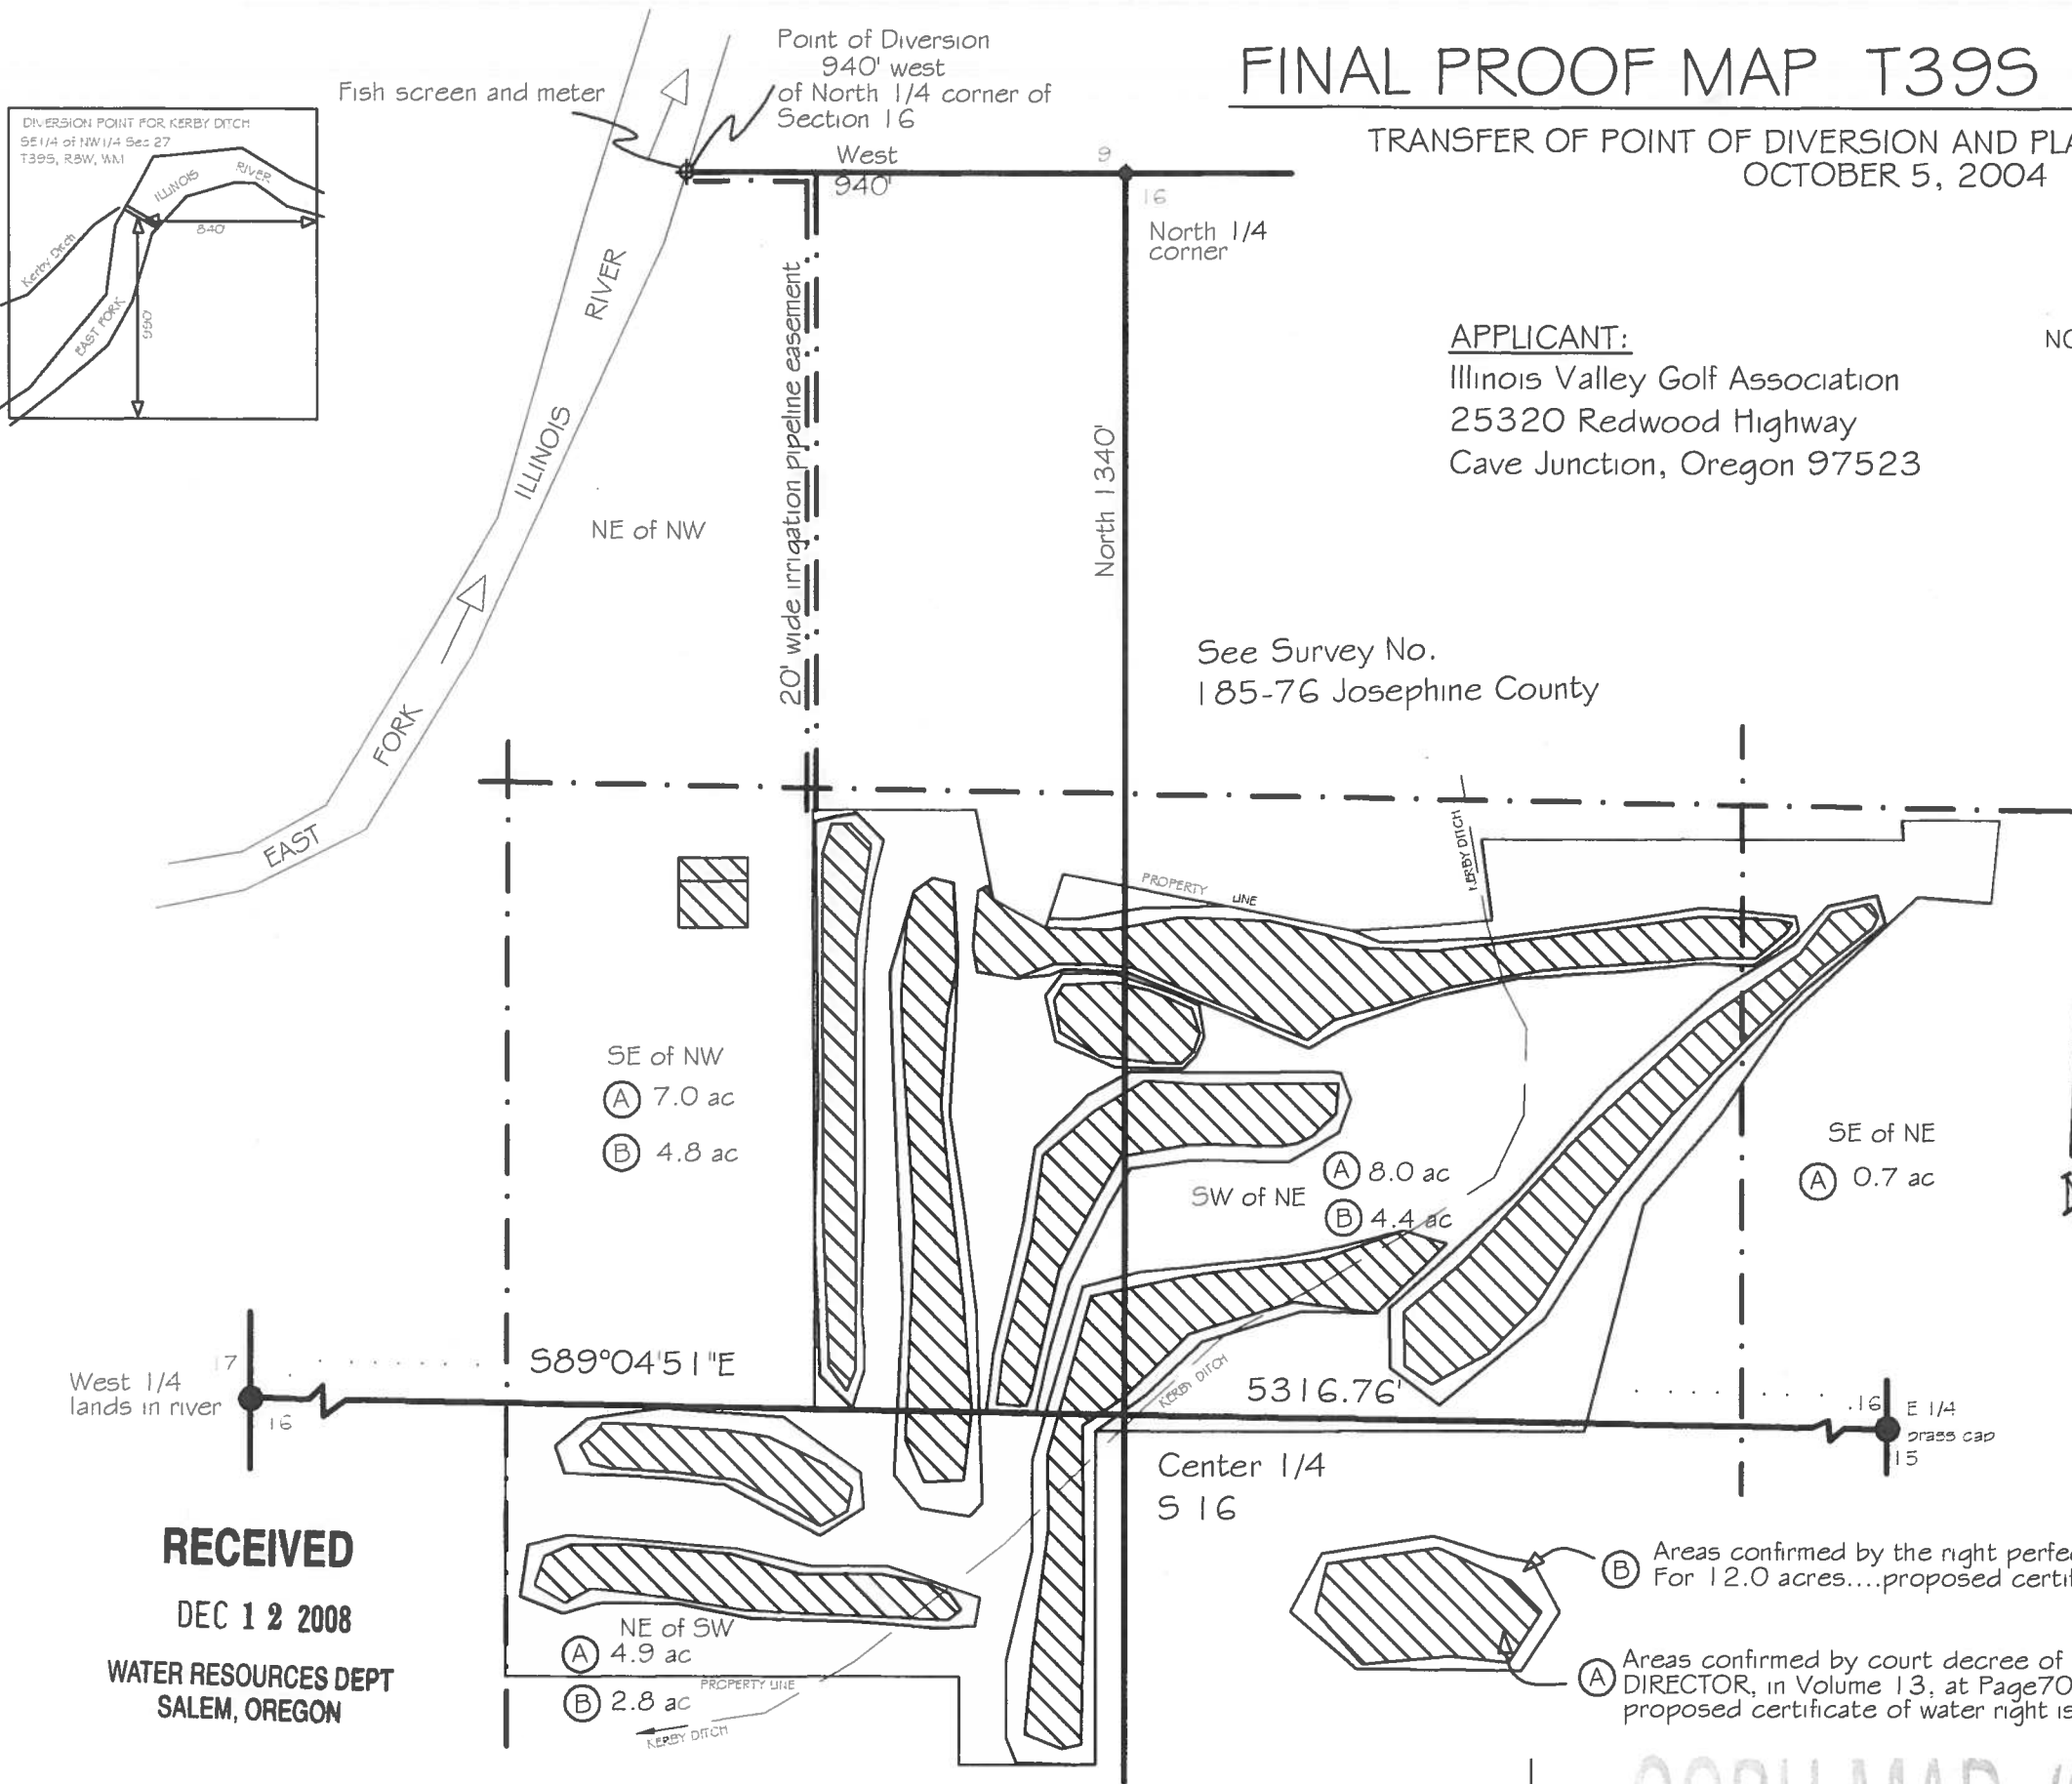

RECEIVED
DEC 12 2008
WATER RESOURCES DEPT
SALEM, OREGON

COBU MAP # 0402

0402