


# T.4S. R.3W. Sec. 21 and 22, W.M.

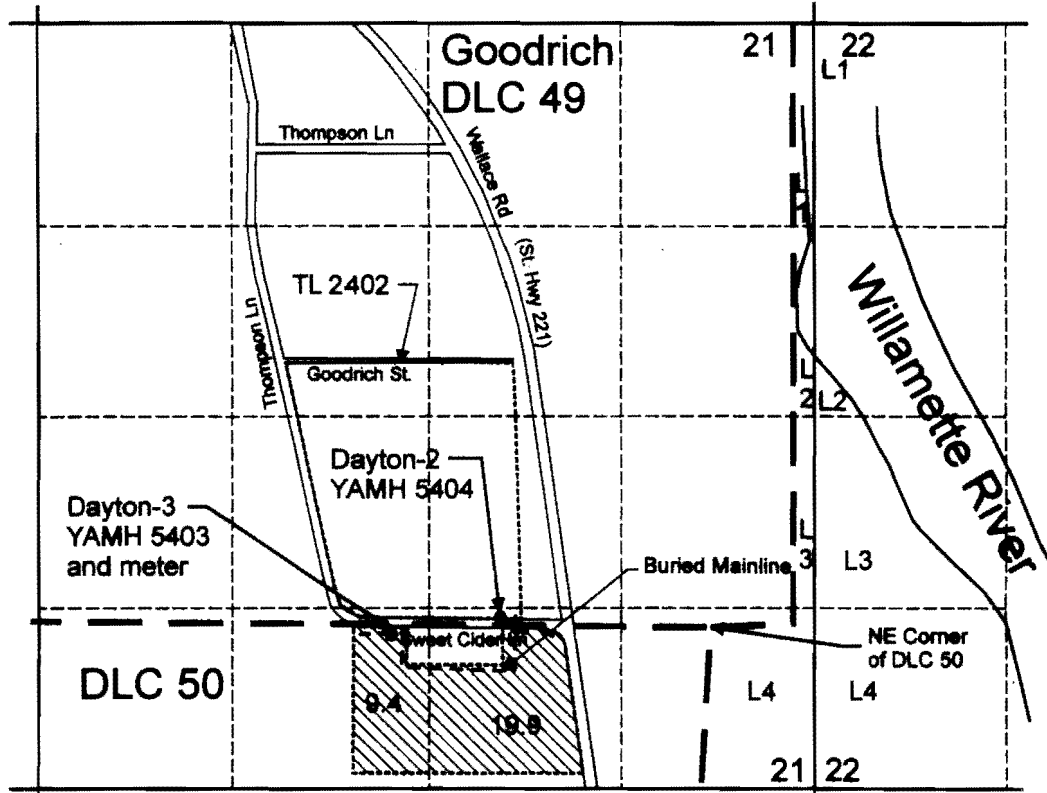

Dayton-2 (YAMH 5404) is located 50 feet north and 1,440 feet west of the NE corner of DLC 50  
 Dayton-3 (YAMH 5403) is located 52 feet south and 2,187 feet west from the NE corner of DLC 50

 Area (29.3 Acres) irrigated under Application S-73278, Permit S-51672.

----- Tax lot boundary

- - - Mainline

RECEIVED


*[Handwritten signature]*  
 JUNE 30, 2009



EXPIRATION DATE: 6/30/09

Note: The quarter quarter lines have been projected using a tax map, government land survey maps, an aerial photograph, and best professional judgement.

Scale: 1" = 1,320'

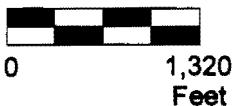

This map was prepared for the purpose of identifying the location of a water right only and is not intended to provide legal dimensions or location of property ownership lines.



Pacific Hydro-Geology Inc.

Claim of Beneficial Use Map  
 Transfer T-9798

Carlton Plants  
 Dayton/Currie Farm

8/2008