


RECEIVED

AUG 24 1999

WATER RESOURCES DEPT  
SALEM, OREGON

TOWNSHIP 5 SOUTH, RANGE 1 WEST, W.M.

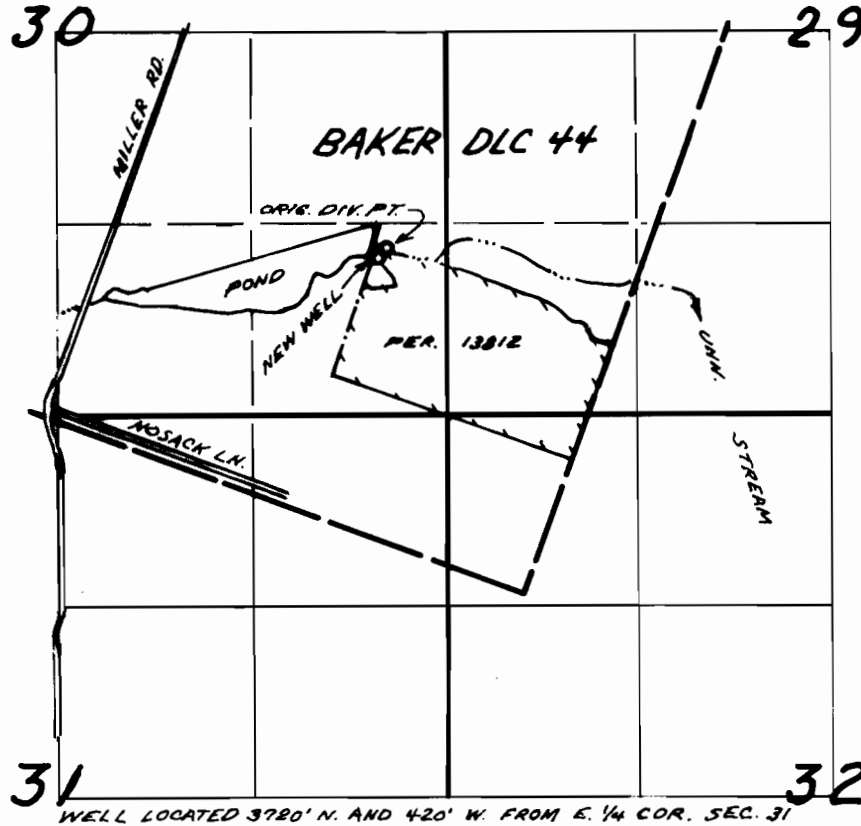

FINAL PROOF SURVEY


UNDER

TRANSFER No. 7659

IN NAME OF

EDER FARMS, INC.

AUG. 16, 1999

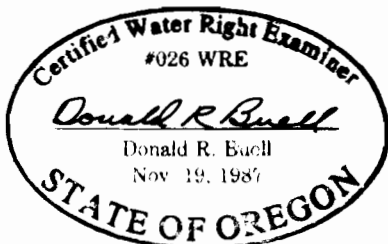

THIS MAP WAS PREPARED FOR THE PURPOSE OF IDENTIFYING THE LOCATION OF A WATER RIGHT ONLY AND IS NOT INTENDED TO PROVIDE LEGAL DIMENSIONS OR LOCATION OF PROPERTY OWNERSHIP LINES.