


FINAL PROOF SURVEY MAP IN THE NAME OF JOSEPH L. SONKA


PERMIT 11867

TRANSFER T-6057 & T-6060

SECTION 6, TOWNSHIP 30 SOUTH, RANGE 5 WEST, W.M.

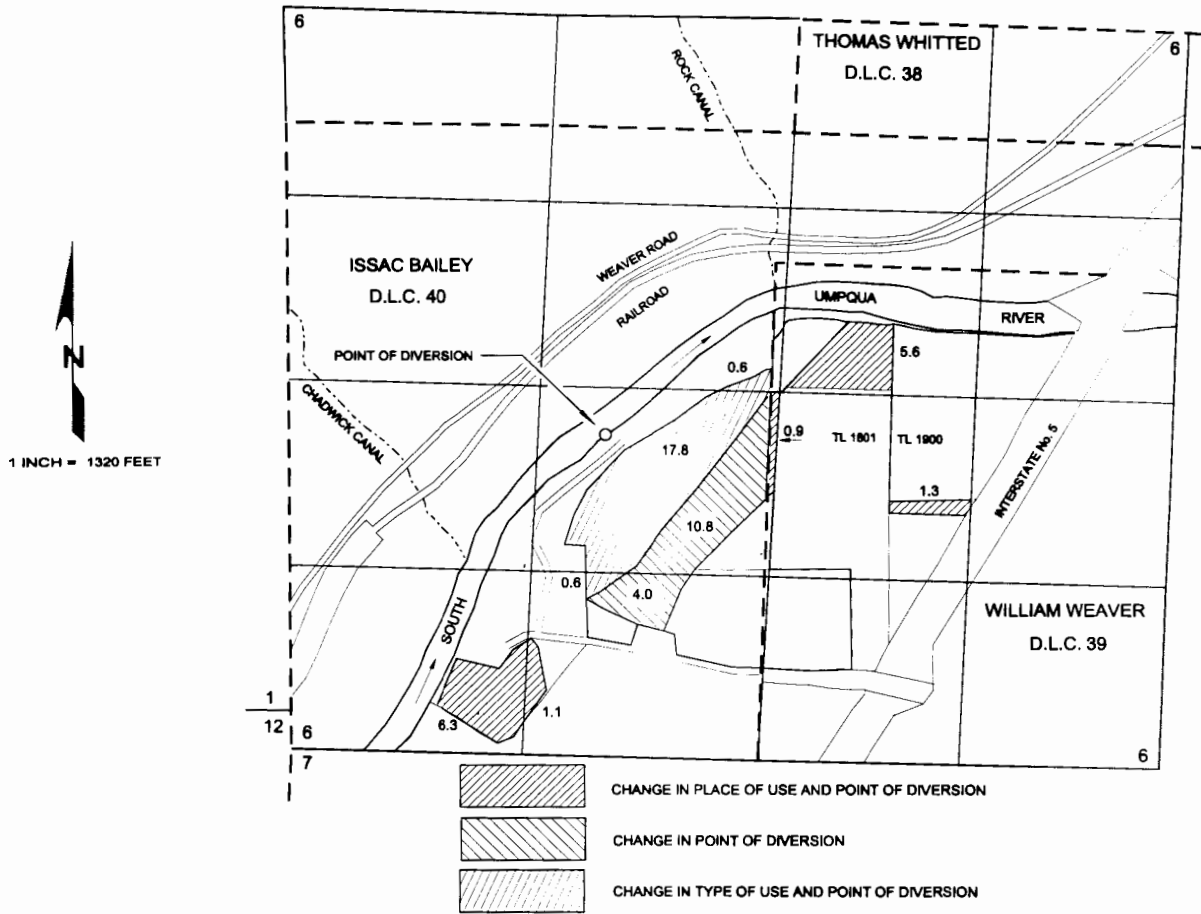

THE POINT OF DIVERSION IS LOCATED 2200 FEET NORTH AND 2140 FEET EAST FROM THE SOUTHWEST CORNER OF SECTION 6; BEING WITHIN THE NE 1/4 SW 1/4, AS PROJECTED WITHIN ISSAC BAILEY D.L.C. 40, OF SECTION 6, TOWNSHIP 30 SOUTH, RANGE 5 WEST, W.M.; DOUGLAS COUNTY.

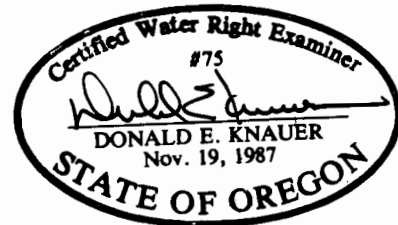

THE PURPOSE OF THIS MAP IS TO IDENTIFY THE LOCATION OF THE WATER RIGHT. IT IS NOT INTENDED TO PROVIDE INFORMATION RELATIVE TO THE LOCATION OF PROPERTY OWNERSHIP BOUNDARY LINES.