

756


No.	REVISIONS	BY
1		
2		
3		
4		
5		
6		
7		

3823 Bond Rd.
LEBANON, OREGON 97055
(503) 255-2190

ERWIN
CONSULTING
ENGINEERING


PLACE OF USE MAP
CITY OF SWEET HOME, OREGON
COVER SHEET

Date: JAN 2013
Scale: AS NOTED
Drawn: RHQ
Job:
Sheet: 1

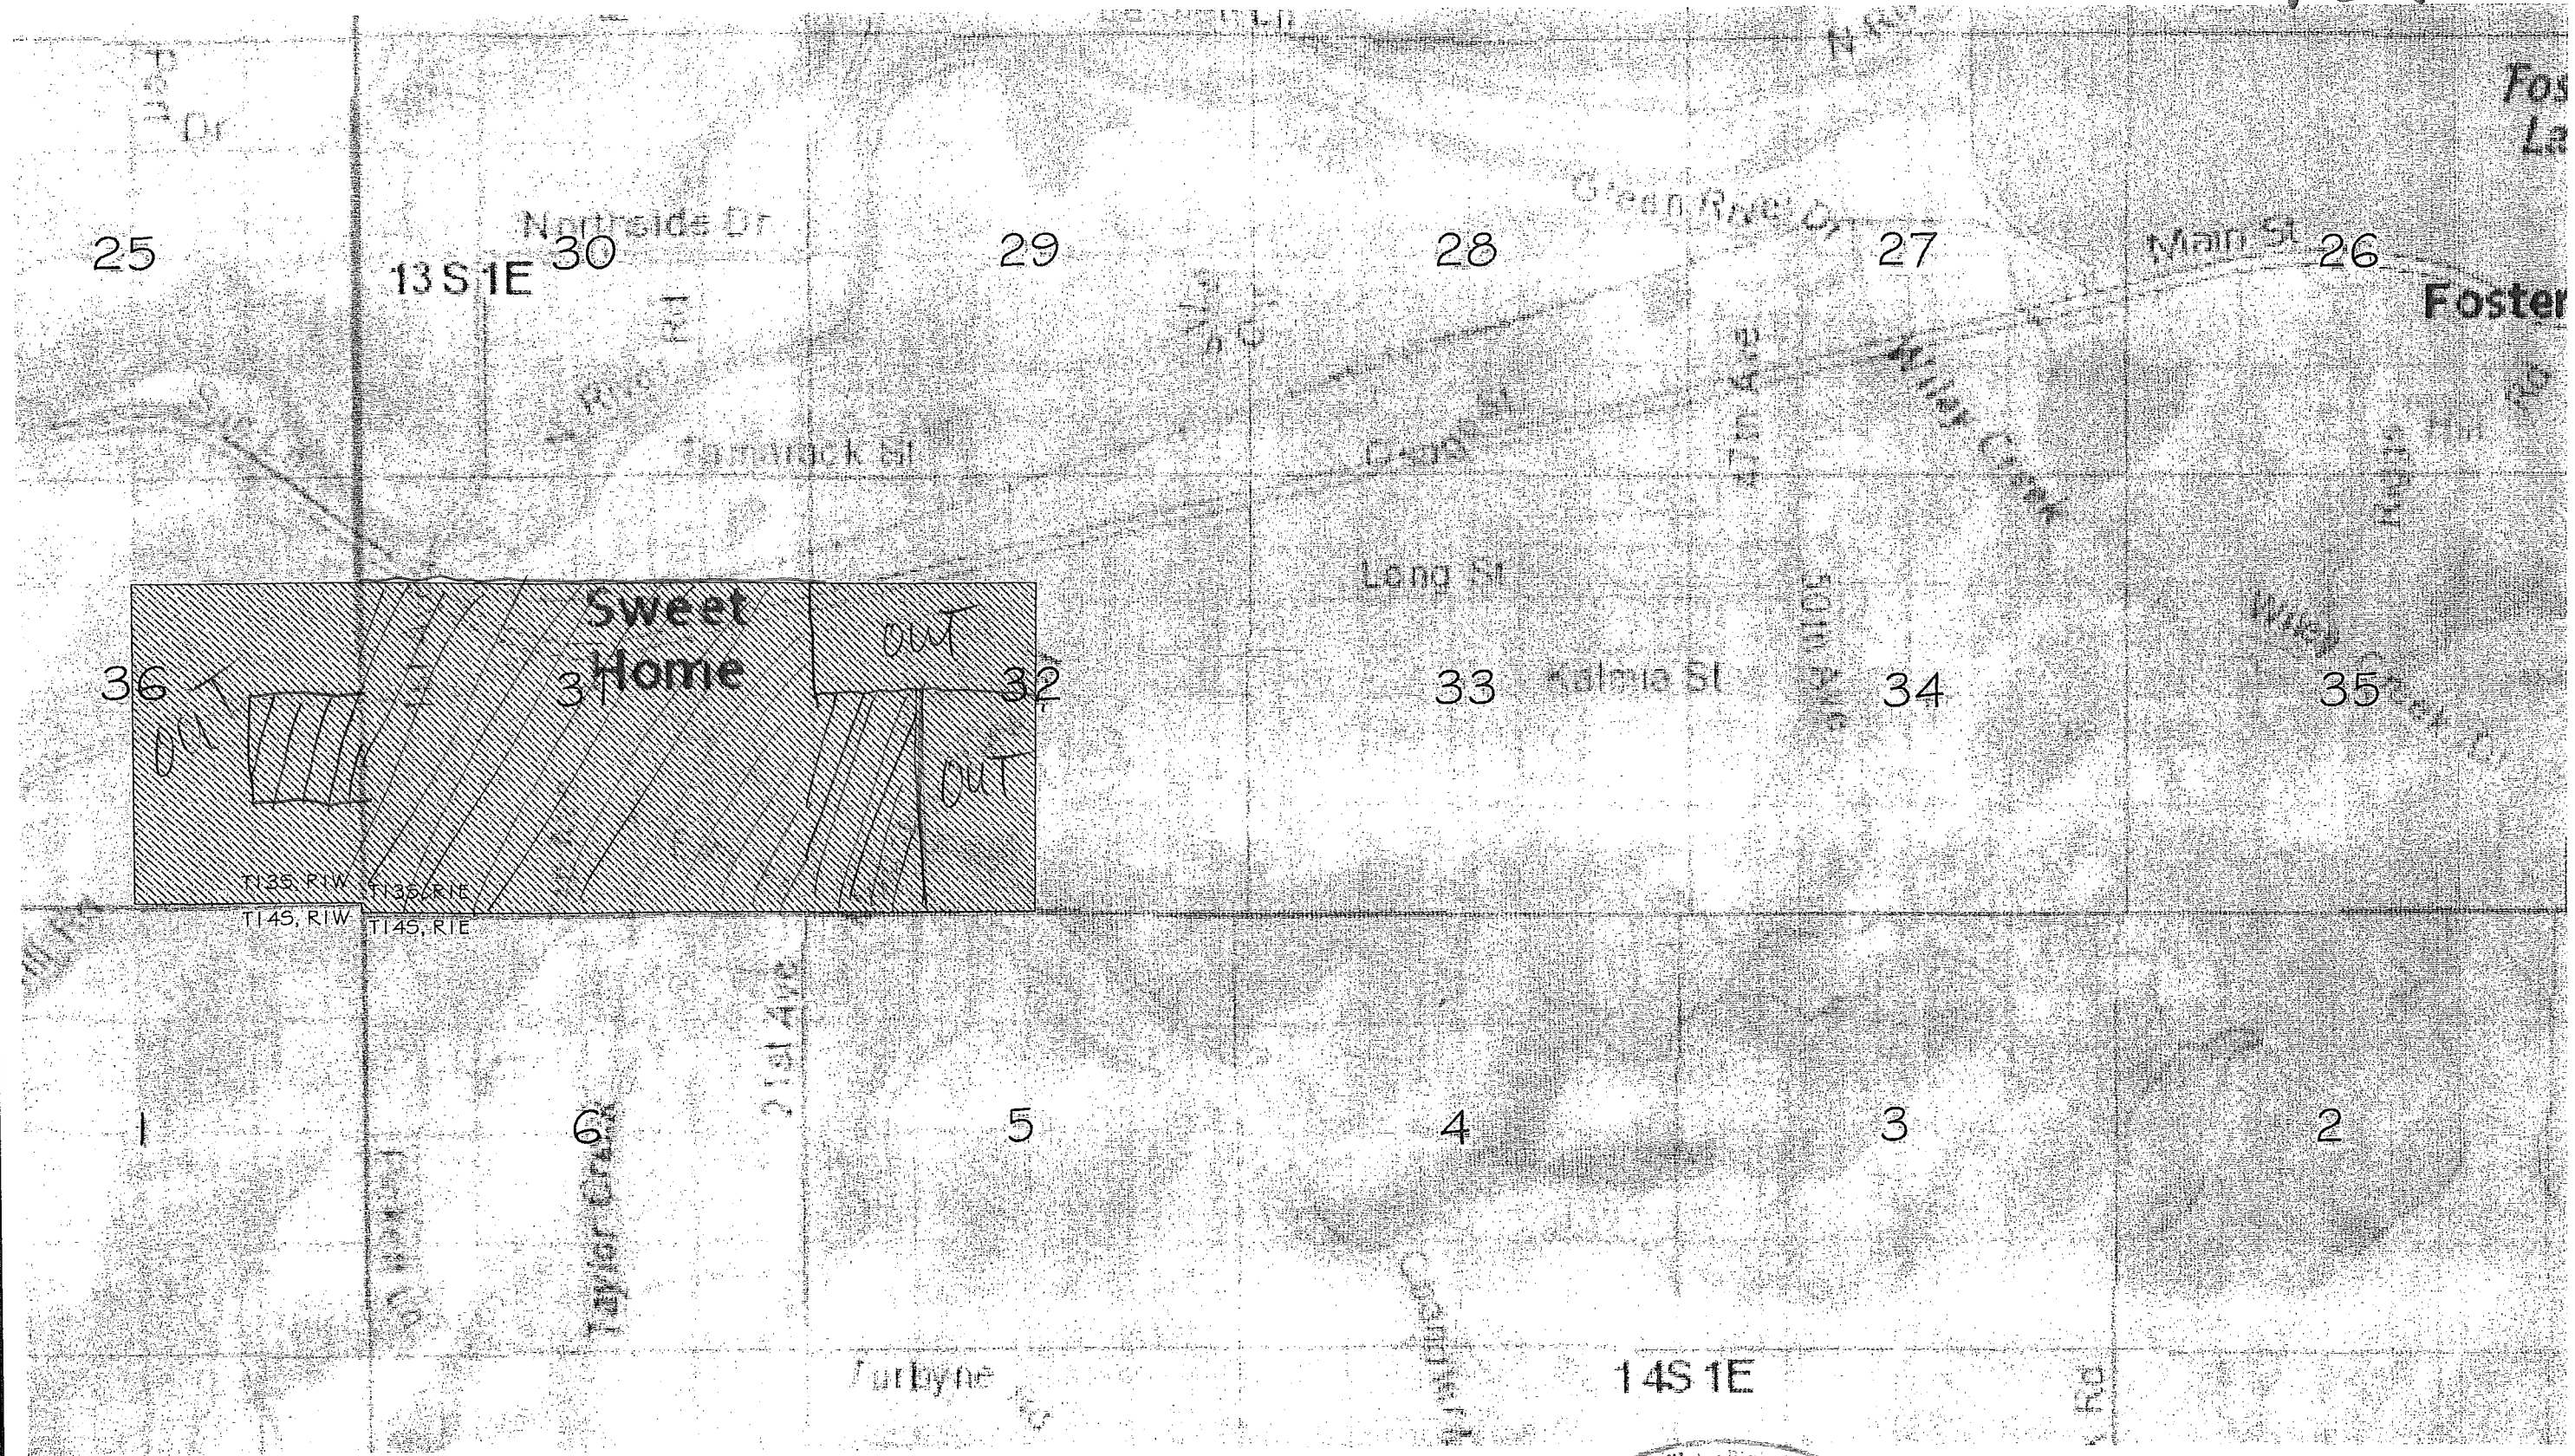

CITY OF SWEET HOME, OR
PLACE OF USE MAP
PERMIT NO.: 13151
TRANSFER: T-8662
0.6 CFS

CORN MAP # 756

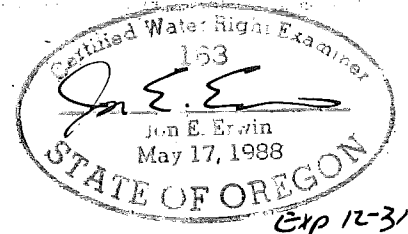


Exp 12-31-2013

0 1,000 2,000
SCALE: 1" = 2,000'




VERIFY SCALE
BAR IS ONE (1) INCH
ON ORIGINAL DRAWING
IF NOT ONE INCH ON THIS SHEET
ADJUST THE SCALE ACCORDINGLY

CLAIM OF BENEFICIAL USE T13S, R1E, WM, SECTION 27/28

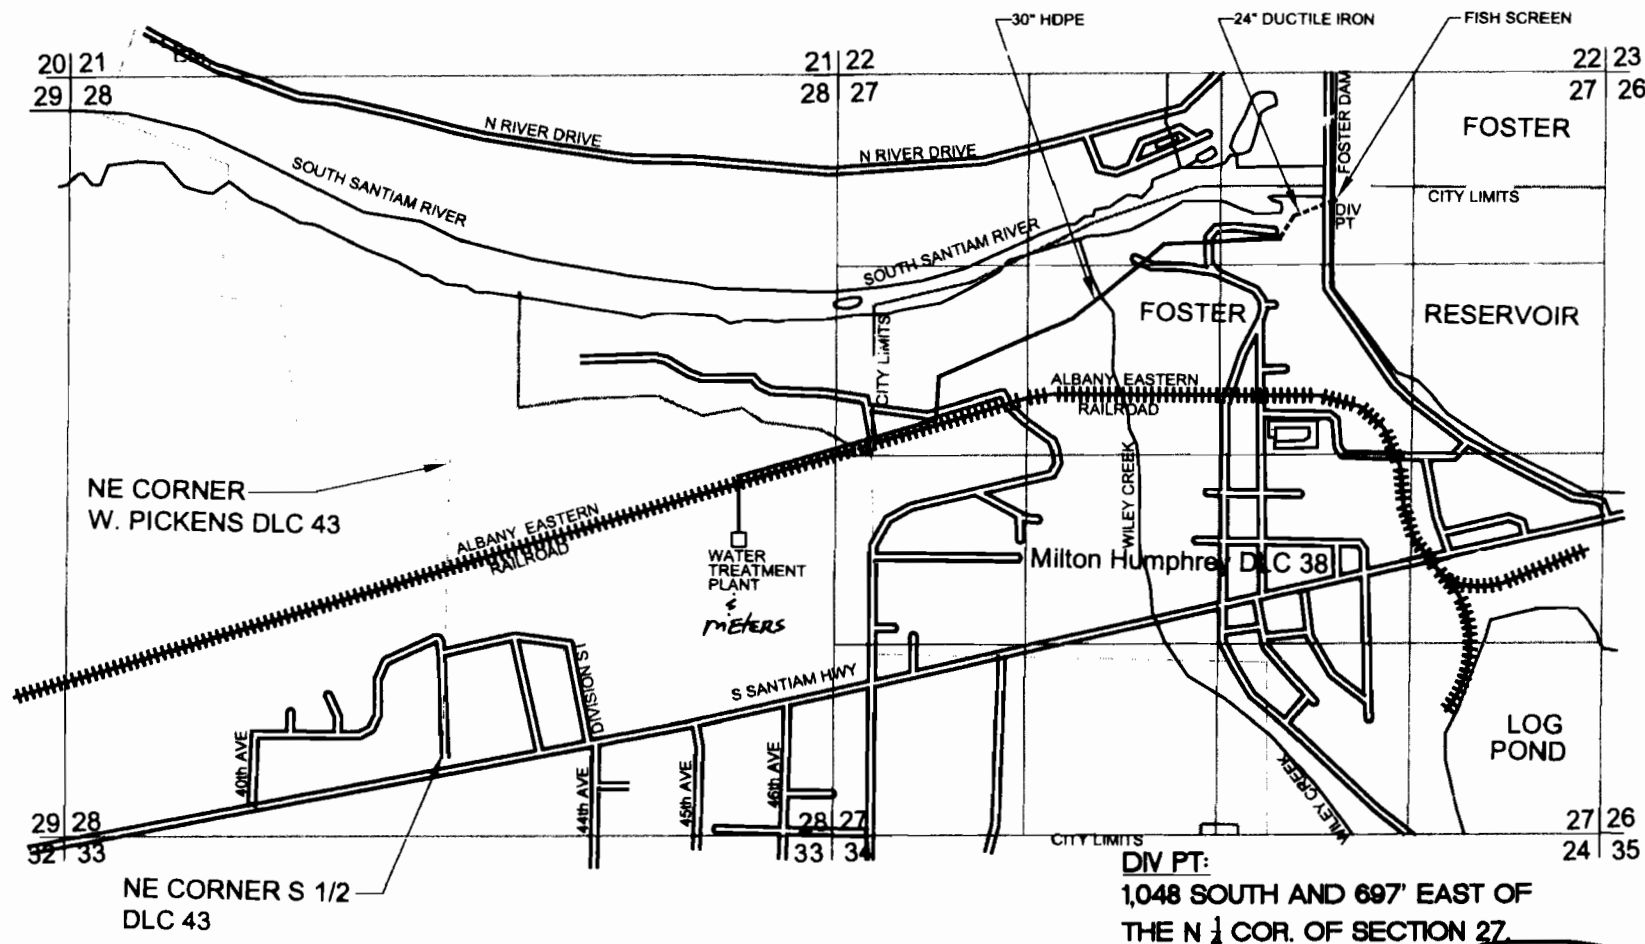

TRANSFER NO.	APPLICATION NO.	PERMIT NO.	CERT. NO.
T8662	17422	13151	13741
T8663	S-25810	20525	
T8664	S-57037	S-49959	

NOTE:
MAP IS FOR THE PURPOSE OF IDENTIFYING THE LOCATION OF WATER RIGHTS AND
HAS NO INTENT TO DIMENSION OR LOCATE PROPERTY OWNERSHIP LINES.

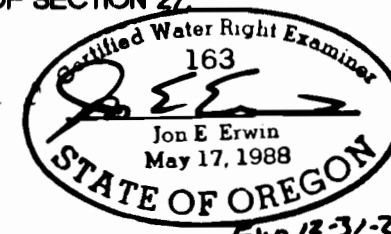

0 1320 2640

SCALE: 1" = 1320'

FOSTER, OREGON
T13S, R1E, Sections 27 + 28.
W.M. LINN COUNTY

Date: 11/9/12
Dwn By: JEE
Scale: 1"=1320'

**ERWIN CONSULTING
ENGINEERING**

53923 BOARD RD.
LEBANON, OR 97036 (503) 269-2390