


CLAIM OF BENEFICIAL USE MAP

UNDER APPLICATION R-85461; PERMIT R-13802

NW1/4 NE1/4 SEC 28 T 20S R 45E W.M.

U.S.G.S. QUAD - MITCHELL BUTTE, OREG. - 7 1/2'

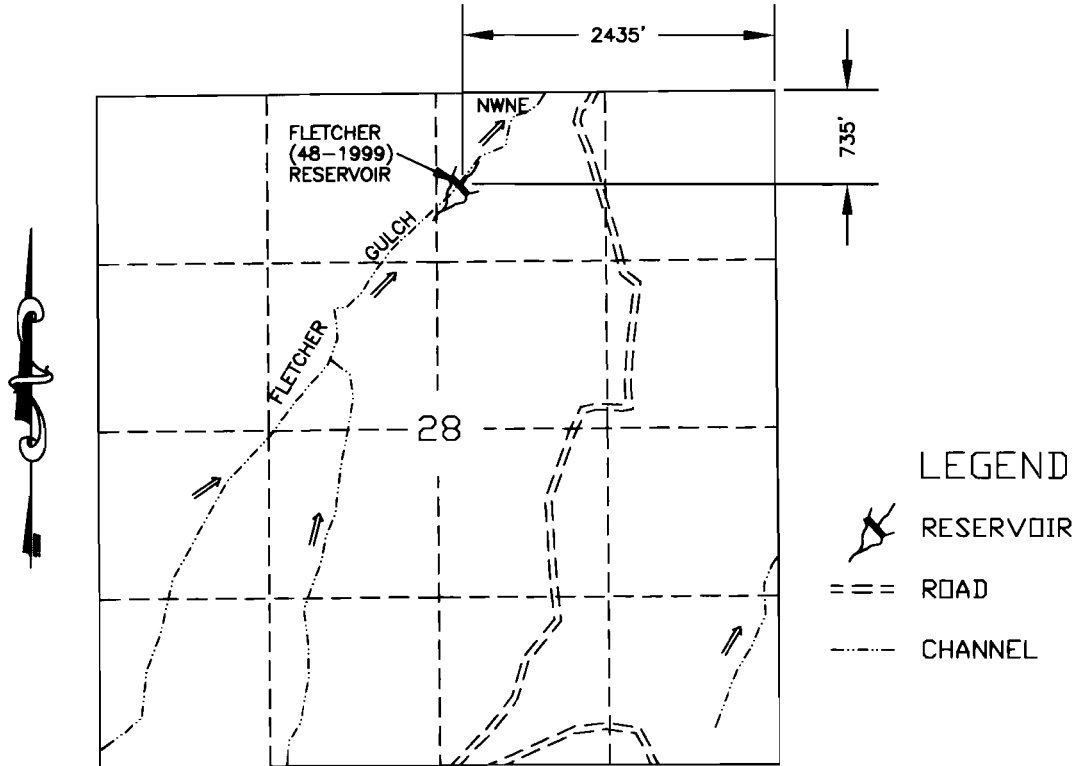

FLETCHER (48-1999) RESERVOIR

MALHEUR COUNTY MAP 20S45E
TAX LOT 100

1320 660 0 1320
SCALE 1"=1320'

I, Charles E. Joy, Administrative Officer, Vale BLM agree to the findings of the CWRE and do submit this site report and map as my Claim of Beneficial Use of the water as provided under the terms and conditions of my Permit R-13802

Charles E. Joy

THIS MAP IS FOR THE PURPOSE OF LOCATING A WATER RIGHT AND IS NOT INTENDED TO PROVIDE LEGAL DIMENSIONS FOR LOCATION OF PROPERTY BOUNDARIES.



ACAD2006
DWG FILE FLETCHER-BENE

UNITED STATES DEPARTMENT OF THE INTERIOR BUREAU OF LAND MANAGEMENT DIVISION OF OPERATIONS VALE DISTRICT	
FLETCHER (48-1999) RESERVOIR	
DESIGNED:	<i>Charles E. Joy</i>
REVIEWED:	<i>Charles E. Joy</i>
APPROVED:	<i>Charles E. Joy</i>
ADMINISTRATIVE AND FIELD SERVICES	
DRAWN: CG	SCALE: 1"=1320'
DATE: 09/04/07	SHEET 1 OF 1
DRAWING NO. OR-03-9172.45-1001	

RECEIVED

MAY 05 2008

WATER RESOURCES DEPT
SALEM, OREGON