

RECEIVED

MAY 05 2008


CLAIM OF BENEFICIAL USE MAP

WATER RESOURCES DEPT
SALEM, OREGON

UNDER APPLICATION R-85605; PERMIT R-13787

SW1/4 SE1/4 SEC 31 T 40S R 47E W.M.

U.S.G.S. QUAD - OREGON BUTTE, OREG. - 7 1/2'

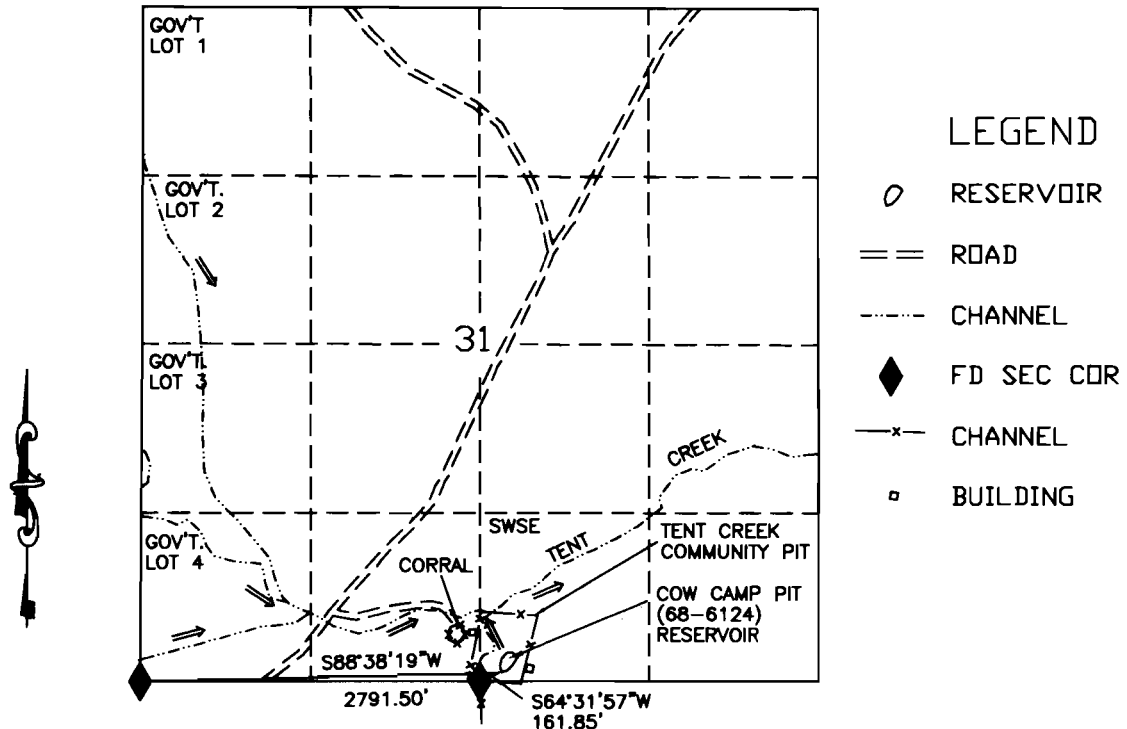

COW CAMP PIT (68-6124) RESERVOIR

MALHEUR COUNTY MAP 40S47E
TAX LOT 100

1320 660 0 1320
SCALE 1"=1320'

I, Charles E. Joy, Administrative Officer, Vale BLM agree to the findings of the CWRE and do submit this site report and map as my Claim of Beneficial Use of the water as provided under the terms and conditions of my Permit R-13787

Charles E. Joy

THIS MAP IS FOR THE PURPOSE OF LOCATING A WATER RIGHT AND IS NOT INTENDED TO PROVIDE LEGAL DIMENSIONS FOR LOCATION OF PROPERTY BOUNDARIES.



ACAB2006
DWG FILE: WCAWPT-BEN

UNITED STATES DEPARTMENT OF THE INTERIOR BUREAU OF LAND MANAGEMENT DIVISION OF OPERATIONS VALE DISTRICT	
COW CAMP PIT (68-6124) RESERVOIR	
DESIGNED:	<i>Vernon R. Putchard</i>
REVIEWED:	<i>Charles E. Joy</i>
APPROVED:	<i>Charles E. Joy</i>
ASH OPERATIONS AND FIELD SERVICES	
DRAWN: CG	SCALE: 1"=1320'
DATE: 09/04/07	SHEET 1 OF 1
DRAWING NO. OR-03-9172.45-881	