


CLAIM OF BENEFICIAL USE MAP

UNDER APPLICATION R-85843; PERMIT R-13865

GOV'T LOT 4 SEC 2 T 23S R 42E W.M.

U.S.G.S. QUAD - HURLEY FLAT, OREG. - 7 1/2'

TIN STOVE
(48-4667)
RESERVOIR

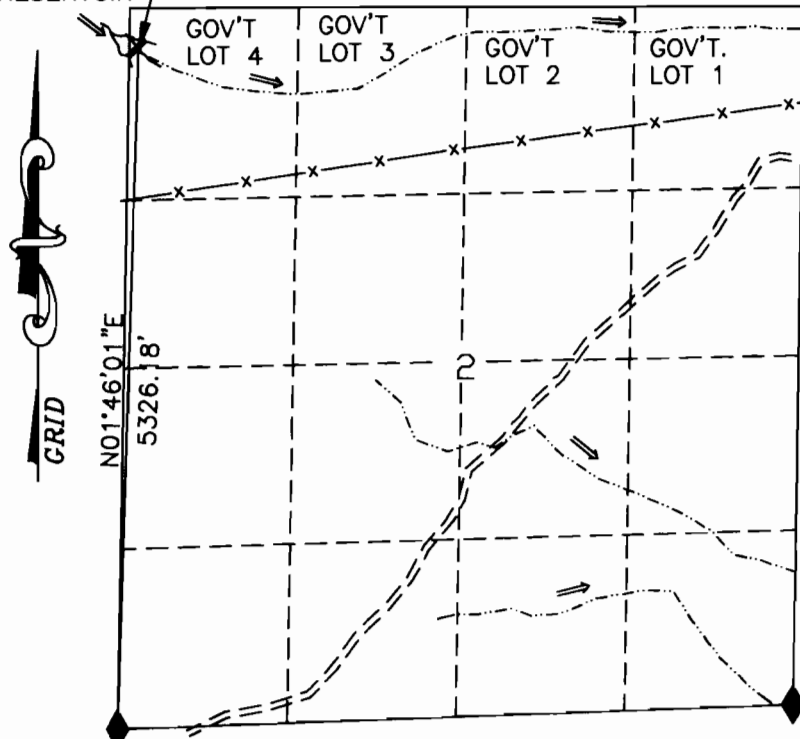


LEGEND

- RESERVOIR
- ROAD
- CHANNEL
- FD SEC COR
- FENCE

TIN STOVE (48-4667) RESERVOIR

LOCATIONS OF THE RESERVOIR AND SECTION CORNER ARE FROM GPS POSITIONS AND THE BEARING IS IN OREGON SOUTH STATE PLANE COORDINATES.

MALHEUR COUNTY MAP 23S42E
TAX LOT 200

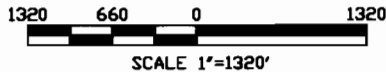

I, Charles E. Joy, Administrative Officer, Vale BLM agree to the findings of the CWRE and do submit this site report and map as my Claim of Beneficial Use of the water as provided under the terms and conditions of my Permit R-13865

Charles E. Joy

THIS MAP IS FOR THE PURPOSE OF LOCATING A WATER RIGHT AND IS NOT INTENDED TO PROVIDE LEGAL DIMENSIONS FOR LOCATION OF PROPERTY BOUNDARIES.



ACAD2006
DWG FILE: TINSTOVEA-BEN

UNITED STATES DEPARTMENT OF THE INTERIOR BUREAU OF LAND MANAGEMENT DIVISION OF OPERATIONS VALE DISTRICT	
TIN STOVE (48-4667) RESERVOIR	
DESIGNED:	<i>Devin R. Paterak</i>
REVIEWED:	<i>Chris E. Joy</i>
APPROVED:	<i>Chris E. Joy</i>
ADM OPERATIONS AND FIELD SERVICES	
DRAWN: CG	SCALE: 1"=1320'
DATE: 09/04/07	SHEET 1 OF 1
DRAWING NO. OR-03-9172.45-1121	

RECEIVED

MAY 05 2008

WATER RESOURCES DEPT
SALEM, OREGON