


CLAIM OF BENEFICIAL USE MAP

UNDER APPLICATION R-85932 ; PERMIT R-13952

GOV'T. LOT 12 SEC 30 T 22S R 39E W.M.

U.S.G.S. QUAD - SHUMWAY RESERVOIR, OREG. - 7 1/2'

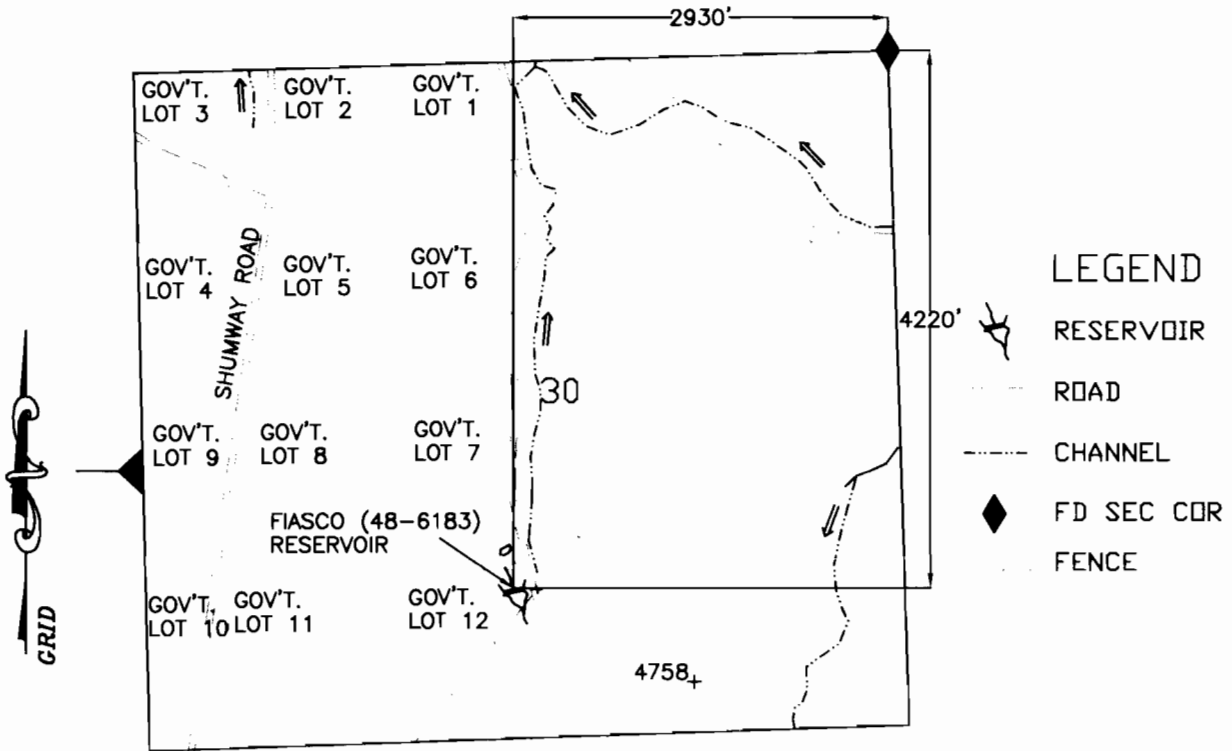

MALHEUR COUNTY MAP 22S39E
TAX LOT 200

FIASCO (48-6183) RESERVOIR

FIASCO LOCATION:
LAT. 43°37'22.77438"
LONG. 117°58'55.04703"

1320 660 0 1320
SCALE 1"=1320'

I, Charles E. Joy, Administrative Officer, Vale BLM agree to the findings of the CWRE and do submit this site report and map as my Claim of Beneficial Use of the water as provided under the terms and conditions of my Permit R-13952

Charles E. Joy

THIS MAP IS FOR THE PURPOSE OF LOCATING A WATER RIGHT AND IS NOT INTENDED TO PROVIDE LEGAL DIMENSIONS FOR LOCATION OF PROPERTY BOUNDARIES.



ACAD2006
DWG FILEFIASCO-BENE

UNITED STATES DEPARTMENT OF THE INTERIOR BUREAU OF LAND MANAGEMENT DIVISION OF OPERATIONS VALE DISTRICT	
FIASCO (48-6183) RESERVOIR	
DESIGNED:	<i>Deanna R. Pritchard</i>
REVIEWED:	<i>Chris E. Joy</i>
APPROVED:	<i>Chris E. Joy</i>
ADM OPERATIONS AND FIELD SERVICES	
DRAWN: CG	SCALE: 1"=1320'
DATE: 09/04/07	SHEET 1 OF 1
DRAWING NO. DR-03-9172.45-1219	

RECEIVED

MAY 05 2008

WATER RESOURCES DEPT
SALEM, OREGON