

FINAL PROOF SURVEY  
 UNDER  
 APPLICATION No. T-1106


RECEIVED

SEP 20 1999


WATER RESOURCES DEPT  
 SALMON DIVISION

AUGUST 25, 1999

T20S, R3W, W.M.  
 5/15/2013 WRD

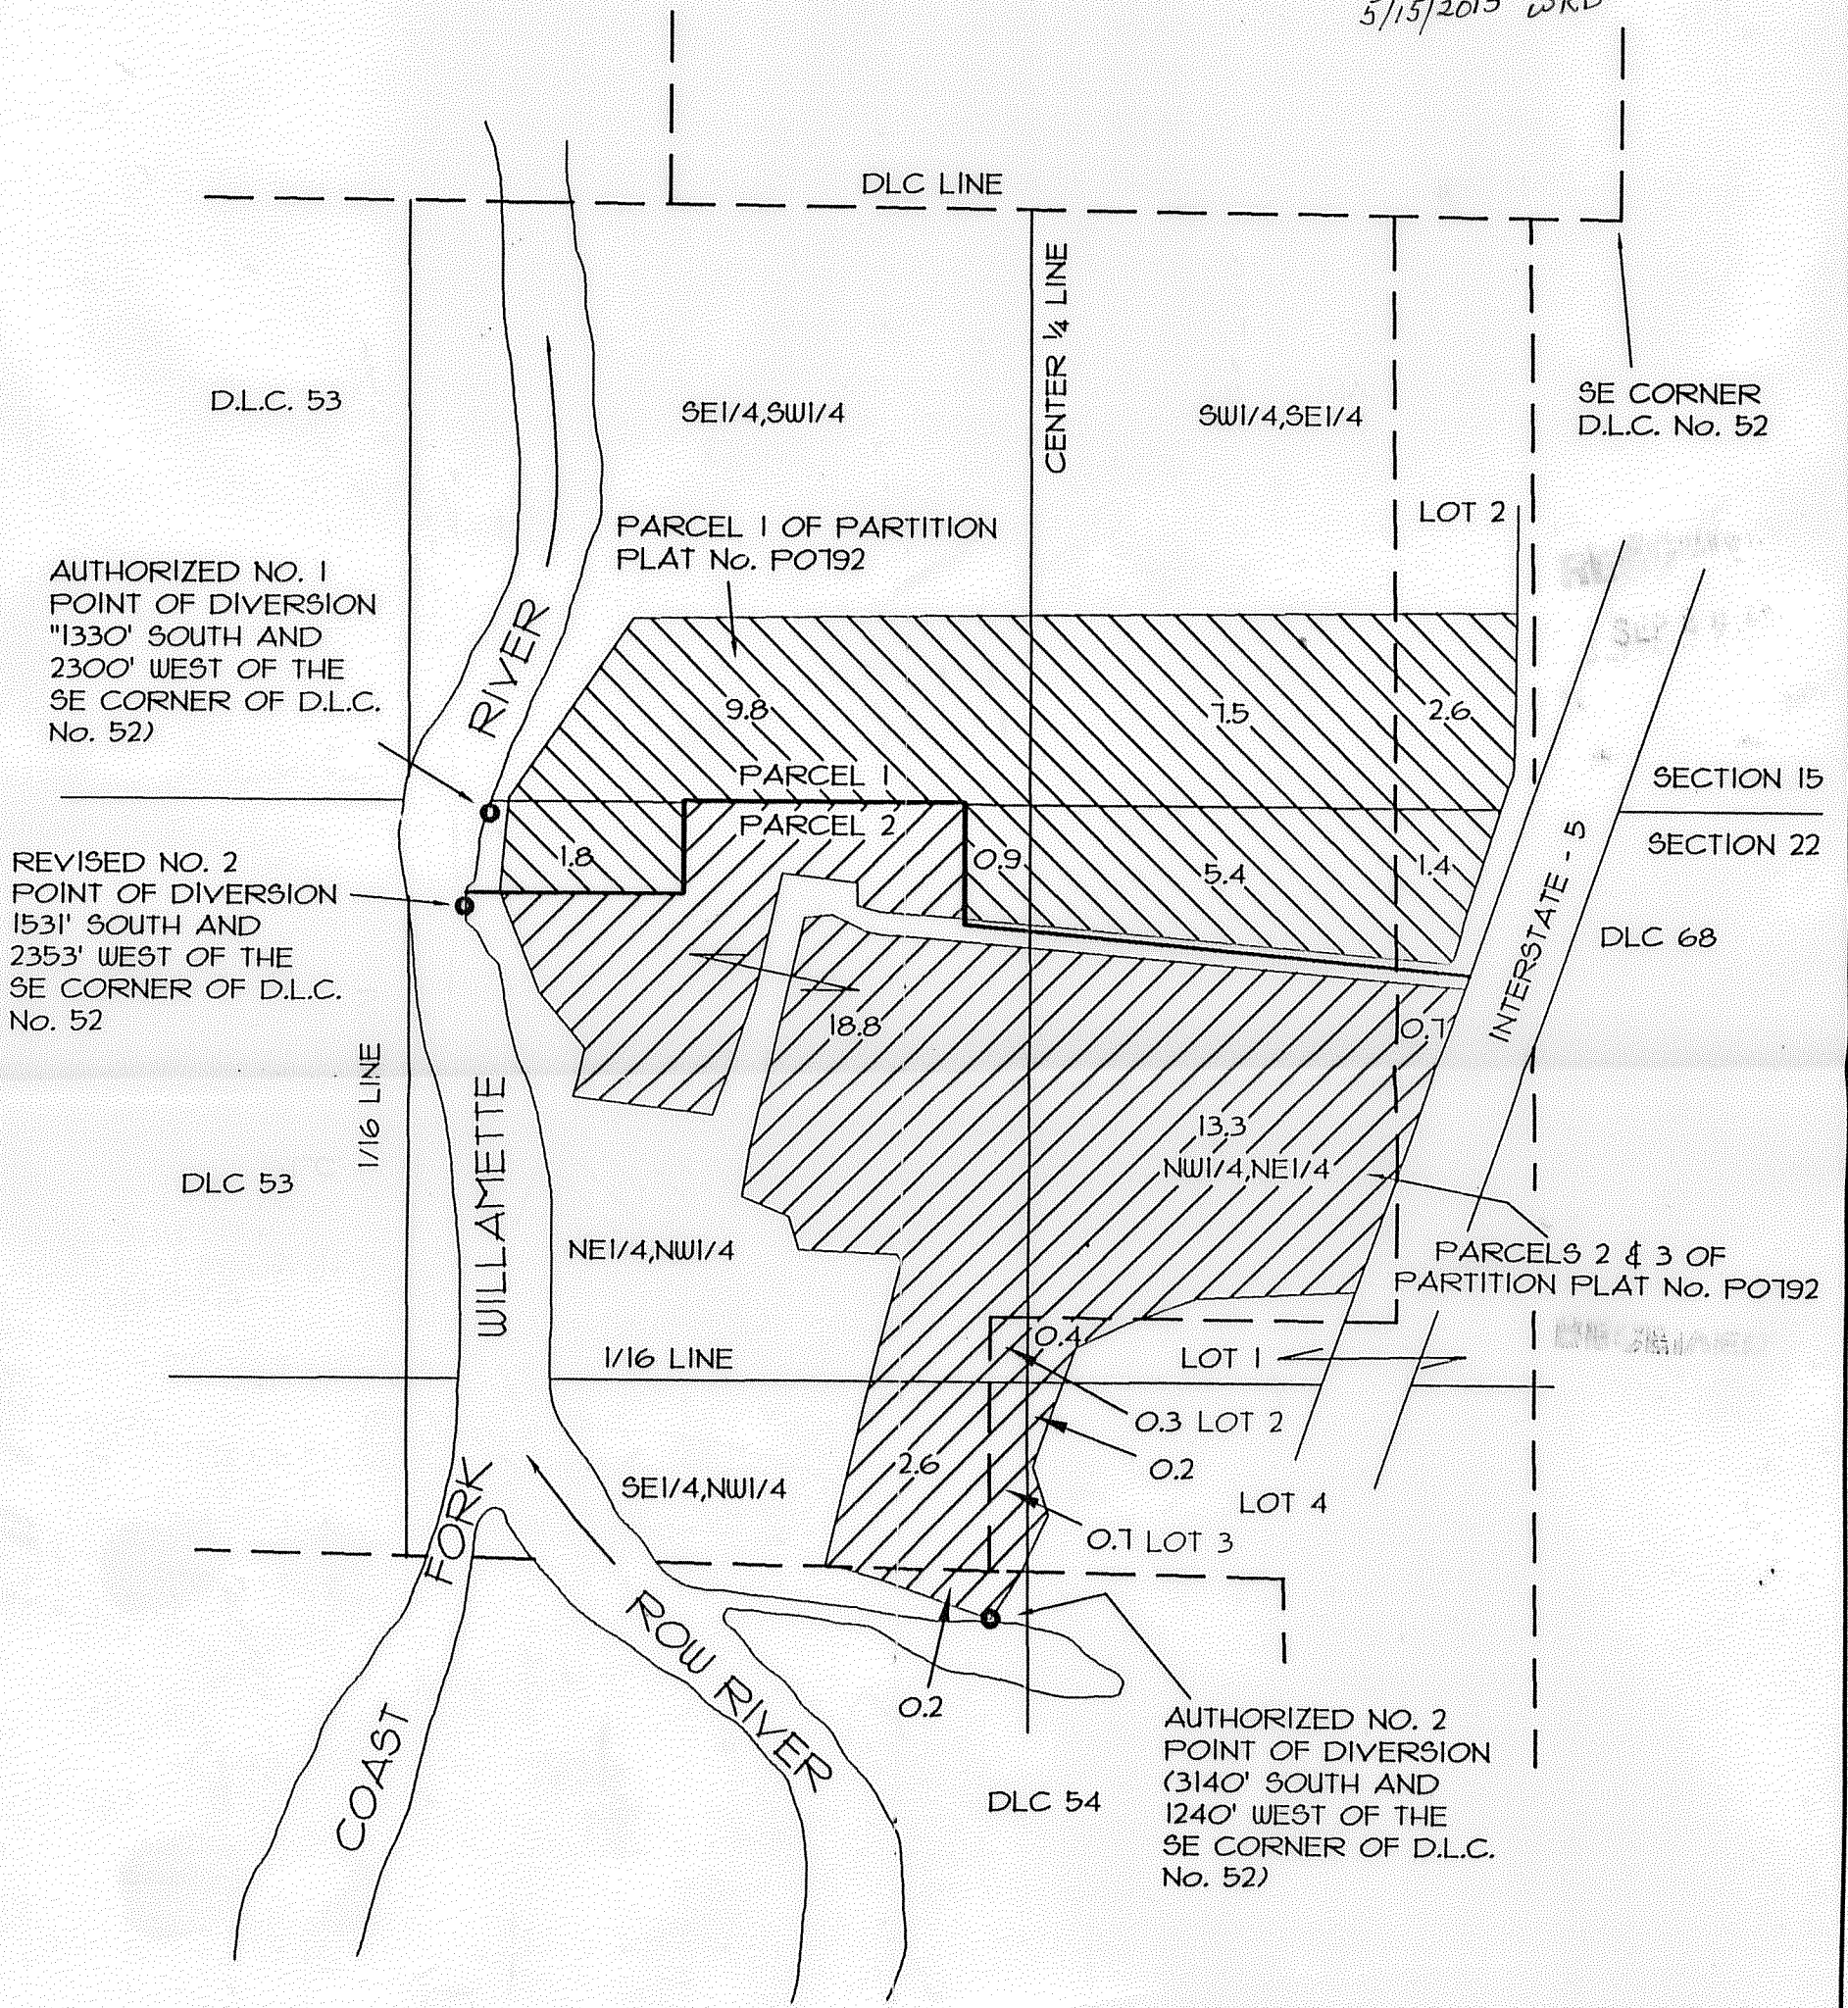

SCALE: 1" = 400'

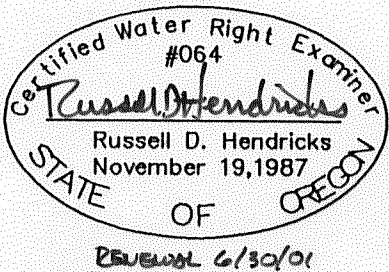

THIS MAP IS FOR THE PURPOSE  
 OF IDENTIFYING THE WATER RIGHT  
 ONLY AND IS NOT INTENDED TO  
 PROVIDE LEGAL DIMENSIONS OR  
 LOCATIONS OF PROPERTY  
 OWNERSHIP LINES.