

# TOWNSHIP 5 NORTH, RANGE 36 EAST, W.M.



CLAIM OF BENEFICIAL USE - FINAL PROOF MAP

WATER RIGHT TRANSFER T-8437

**RECEIVED**

MAY 20 2004

WATER RESOURCES DEPT  
SALEM, OREGON

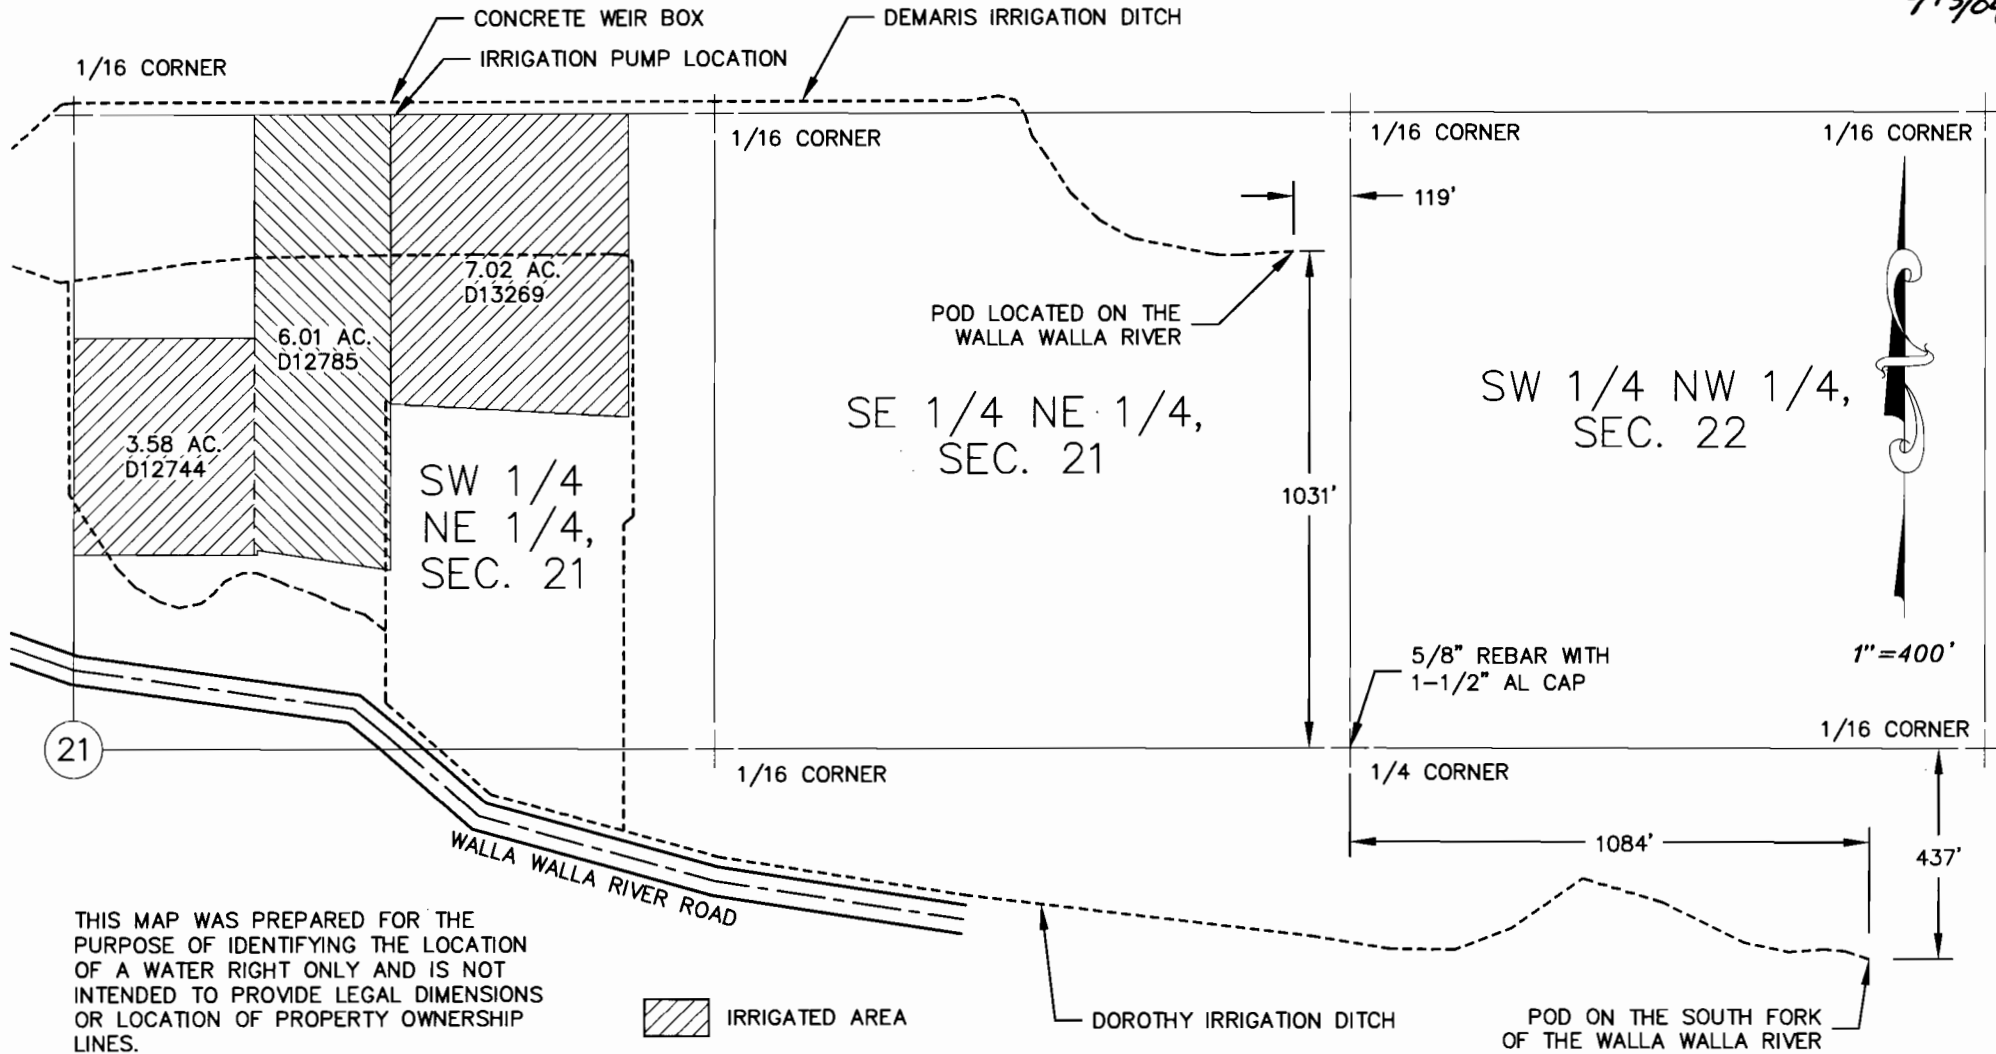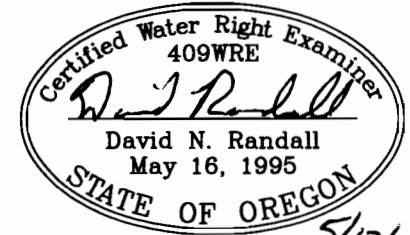

THIS MAP WAS PREPARED FOR THE PURPOSE OF IDENTIFYING THE LOCATION OF A WATER RIGHT ONLY AND IS NOT INTENDED TO PROVIDE LEGAL DIMENSIONS OR LOCATION OF PROPERTY OWNERSHIP LINES.

 IRRIGATED AREA

DOROTHY IRRIGATION DITCH

POD ON THE SOUTH FORK OF THE WALLA WALLA RIVER