

TOWNSHIP 5 NORTH, RANGE 36 EAST, W.M.


CLAIM OF BENEFICIAL USE – FINAL PROOF MAP

WATER RIGHT TRANSFER T-8437

RECEIVED

MAY 20 2004

**WATER RESOURCES DEPT
SALEM, OREGON**

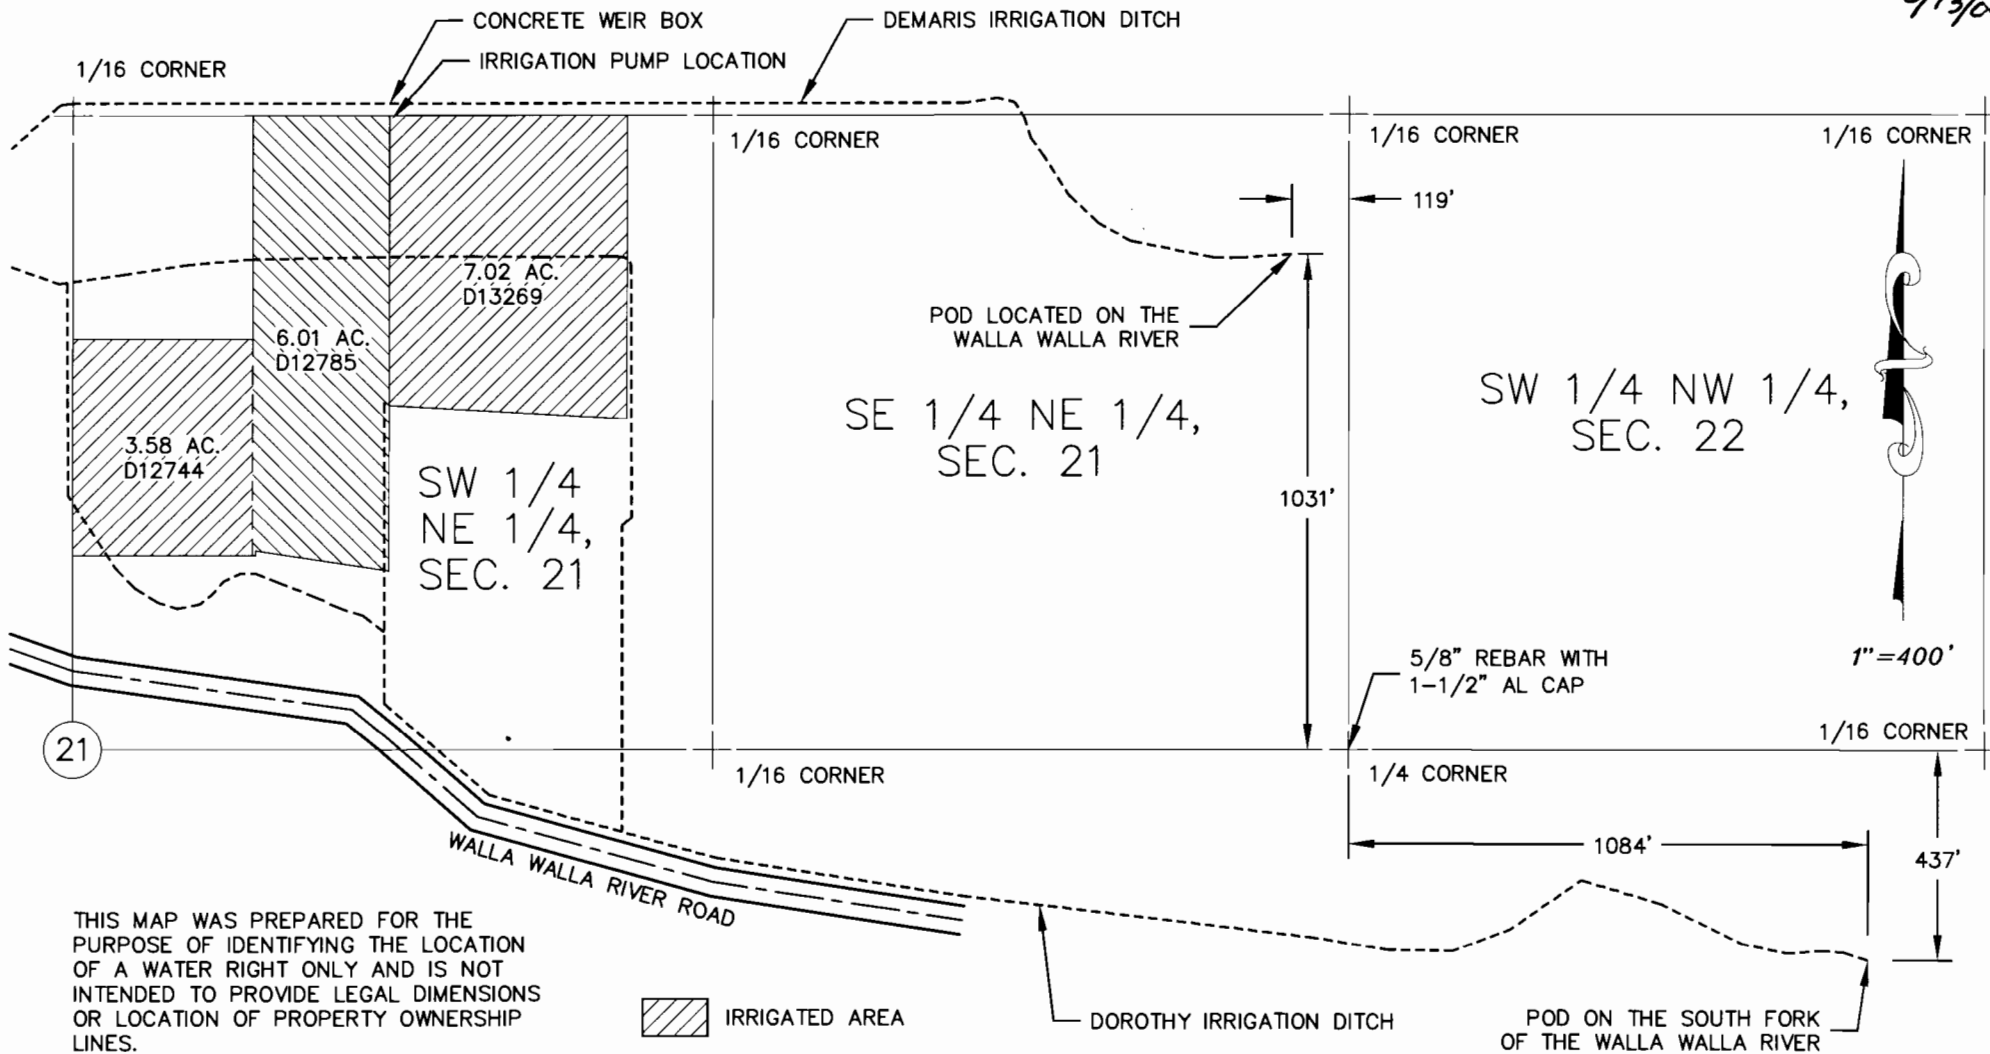

THIS MAP WAS PREPARED FOR THE PURPOSE OF IDENTIFYING THE LOCATION OF A WATER RIGHT ONLY AND IS NOT INTENDED TO PROVIDE LEGAL DIMENSIONS OR LOCATION OF PROPERTY OWNERSHIP LINES.