

FINAL PROOF SURVEY MAP
T30S, R36E, WM
 SCALE 1" = 2000'
 HARNEY COUNTY

Corrected Map May 2012

FINAL PROOF SURVEY
 UNDER

Application No. R-80954 Permit No. R-12693
 IN NAME OF


John R. Atkinson, et al

Surveyed August 7, 2011 by M E Farr

MAP PREPARED FOR:

NORTHWEST FARM CREDIT SERVICES, FLCA
 JOHN R. ATKINSON & DONNA M. ATKINSON
 RONALD D. ATKINSON & BONNIE A. ATKINSON
 JOHN R. ATKINSON, Trustee of the
 JOHN R. and DONNA M. ATKINSON TRUST
 DONNA M. ATKINSON, Trustee of the
 JOHN R. and DONNA M. ATKINSON TRUST
 2823 NW KLINE STREET
 ROSEBURG, OR 97471



THIS IS A LOCATION MAP FOR A FINAL PROOF SURVEY. THIS MAP IS FOR THE PURPOSE OF IDENTIFYING THE LOCATION OF THE WATER RIGHT ONLY AND IS NOT INTENDED TO PROVIDE LEGAL DIMENSIONS OR LOCATIONS OF PROPERTY OWNERSHIP LINES.

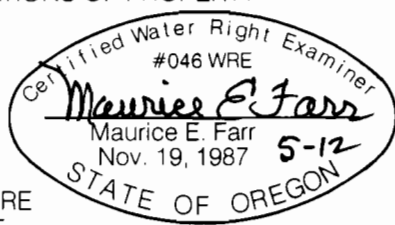

MAP PREPARED BY:
 MAURICE E FARR, CWRE
 395 NE KIRBY AVENUE
 ROSEBURG, OR 97470

EXPIRES 12-31-13

POD 1 is 540 ft S and 3520 ft E from NW COR SEC 9 in Township 30 South, Range 36 East, W.M.

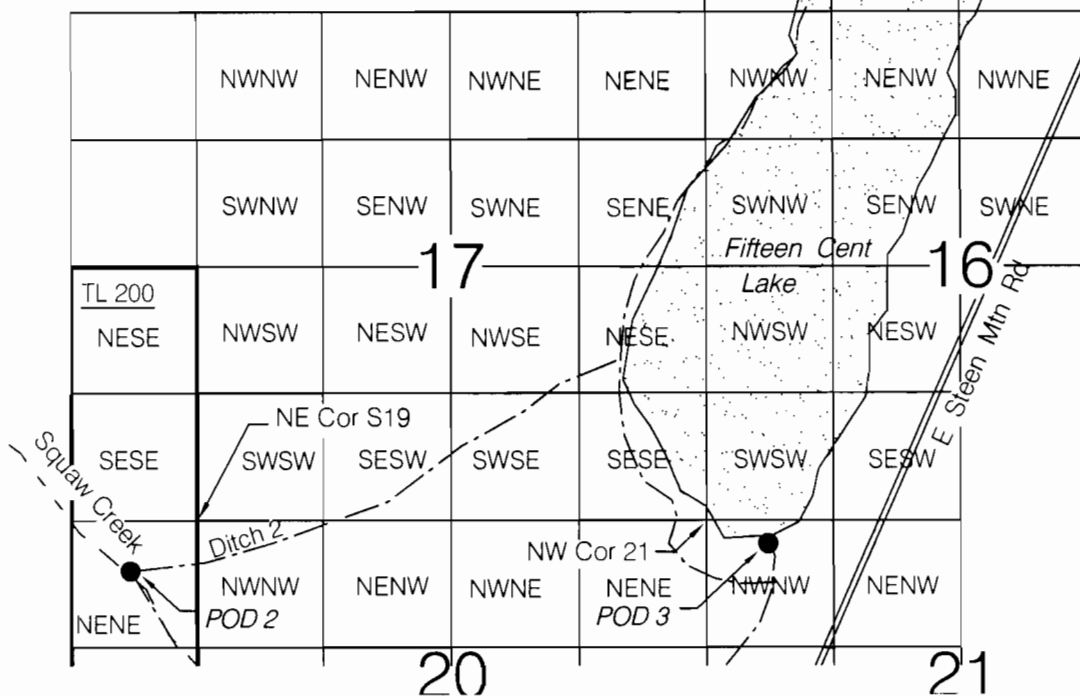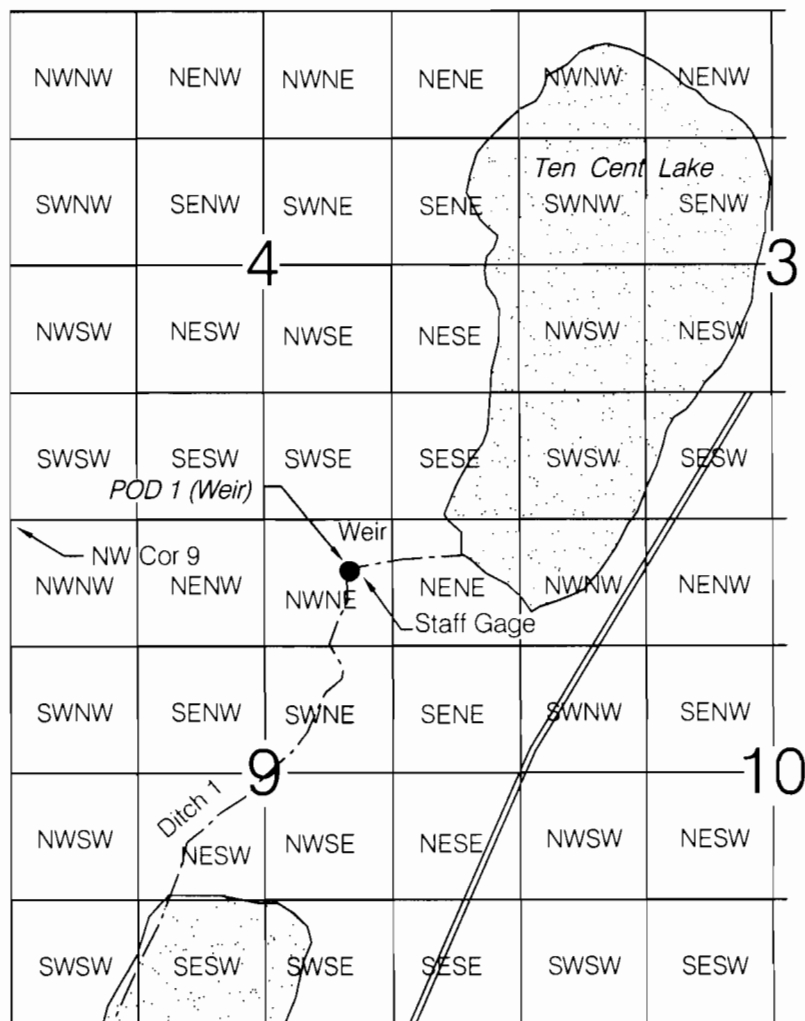

LEGEND

- Existing natural lake
- POD #n
- Stream
- Open supply ditch
- Applicant Property Line