

FINAL PROOF SURVEY MAP
T30S, R36E, WM
SCALE 1" = 2000'
HARNEY COUNTY

RECEIVED

SEP 21 2011

WATER RESOURCES DEPT
SALEM, OREGON

Map 1 OF 3

FINAL PROOF SURVEY
UNDER

Application No. S-80953 Permit No. 53589
IN NAME OF

John R. Atkinson, et al
Surveyed August 7, 2011 by M E Farr

MAP PREPARED FOR:

NORTHWEST FARM CREDIT SERVICES, FLCA
JOHN R. ATKINSON & DONNA M. ATKINSON
RONALD D. ATKINSON & BONNIE A. ATKINSON
JOHN R. ATKINSON, Trustee of the
JOHN R. and DONNA M. ATKINSON TRUST
DONNA M. ATKINSON, Trustee of the
JOHN R. and DONNA M. ATKINSON TRUST
2823 NW KLINE STREET
ROSEBURG, OR 97471


THIS IS A LOCATION MAP FOR A FINAL PROOF
SURVEY. THIS MAP IS FOR THE PURPOSE OF
IDENTIFYING THE LOCATION OF THE WATER RIGHT
ONLY AND IS NOT INTENDED TO PROVIDE LEGAL
DIMENSIONS OR LOCATIONS OF PROPERTY
OWNERSHIP LINES.



MAP PREPARED BY:
MAURICE E FARR, CWRE
395 NE KIRBY AVENUE
ROSEBURG, OR 97470

EXPIRES 12-31-11

POD 1 is 540 ft S and 3520 ft E from NW COR SEC 9
POD 2 is 530 ft S and 700 ft W from NE COR SEC 19
POD 3 is 80 ft S and 680 ft E from NW COR SEC 21
all in Township 30 South, Range 36 East, W.M.

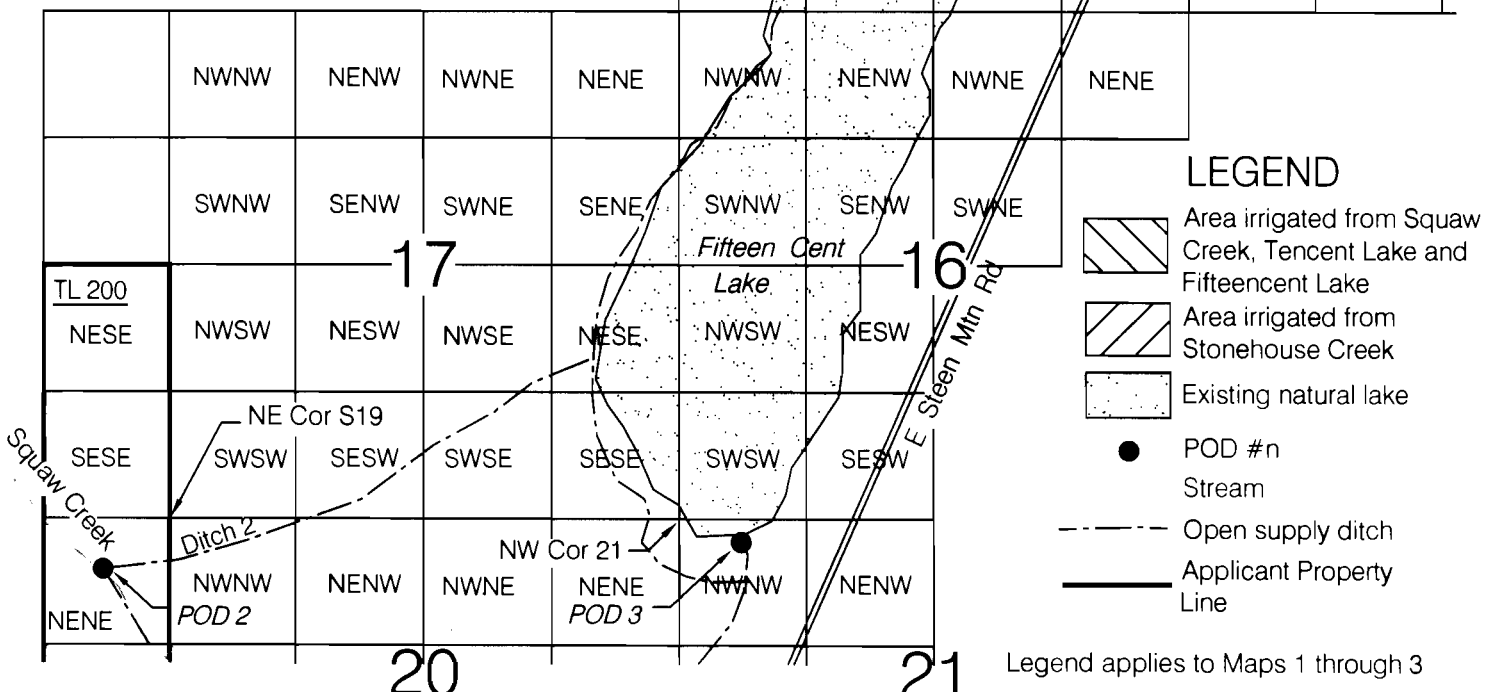

T30S, R35E & 36E,WM

HARNEY COUNTY

Corrected Map May 2012

FINAL PROOF SURVEY
UNDER **RECEIVED**

Application No. S-80953 Permit No. 53589

IN NAME OF **MAY 24 2012**


John R. Atkinson, et al

WATER RESOURCES DEPT
SALEM, OREGON


MAP PREPARED FOR:

NORTHWEST FARM CREDIT SERVICES, FLCA
JOHN R. ATKINSON & DONNA M. ATKINSON
RONALD D. ATKINSON & BONNIE A. ATKINSON
JOHN R. ATKINSON, Trustee of the
JOHN R. and DONNA M. ATKINSON TRUST
DONNA M. ATKINSON, Trustee of the
JOHN R. and DONNA M. ATKINSON TRUST
2823 NW KLINE STREET
ROSEBURG, OR 97471

THIS IS A LOCATION MAP
FOR A FINAL PROOF
SURVEY. THIS MAP IS FOR
THE PURPOSE OF
IDENTIFYING THE
LOCATION OF THE WATER
RIGHT ONLY AND IS NOT
INTENDED TO PROVIDE
LEGAL DIMENSIONS OR
LOCATIONS OF PROPERTY
OWNERSHIP LINES.

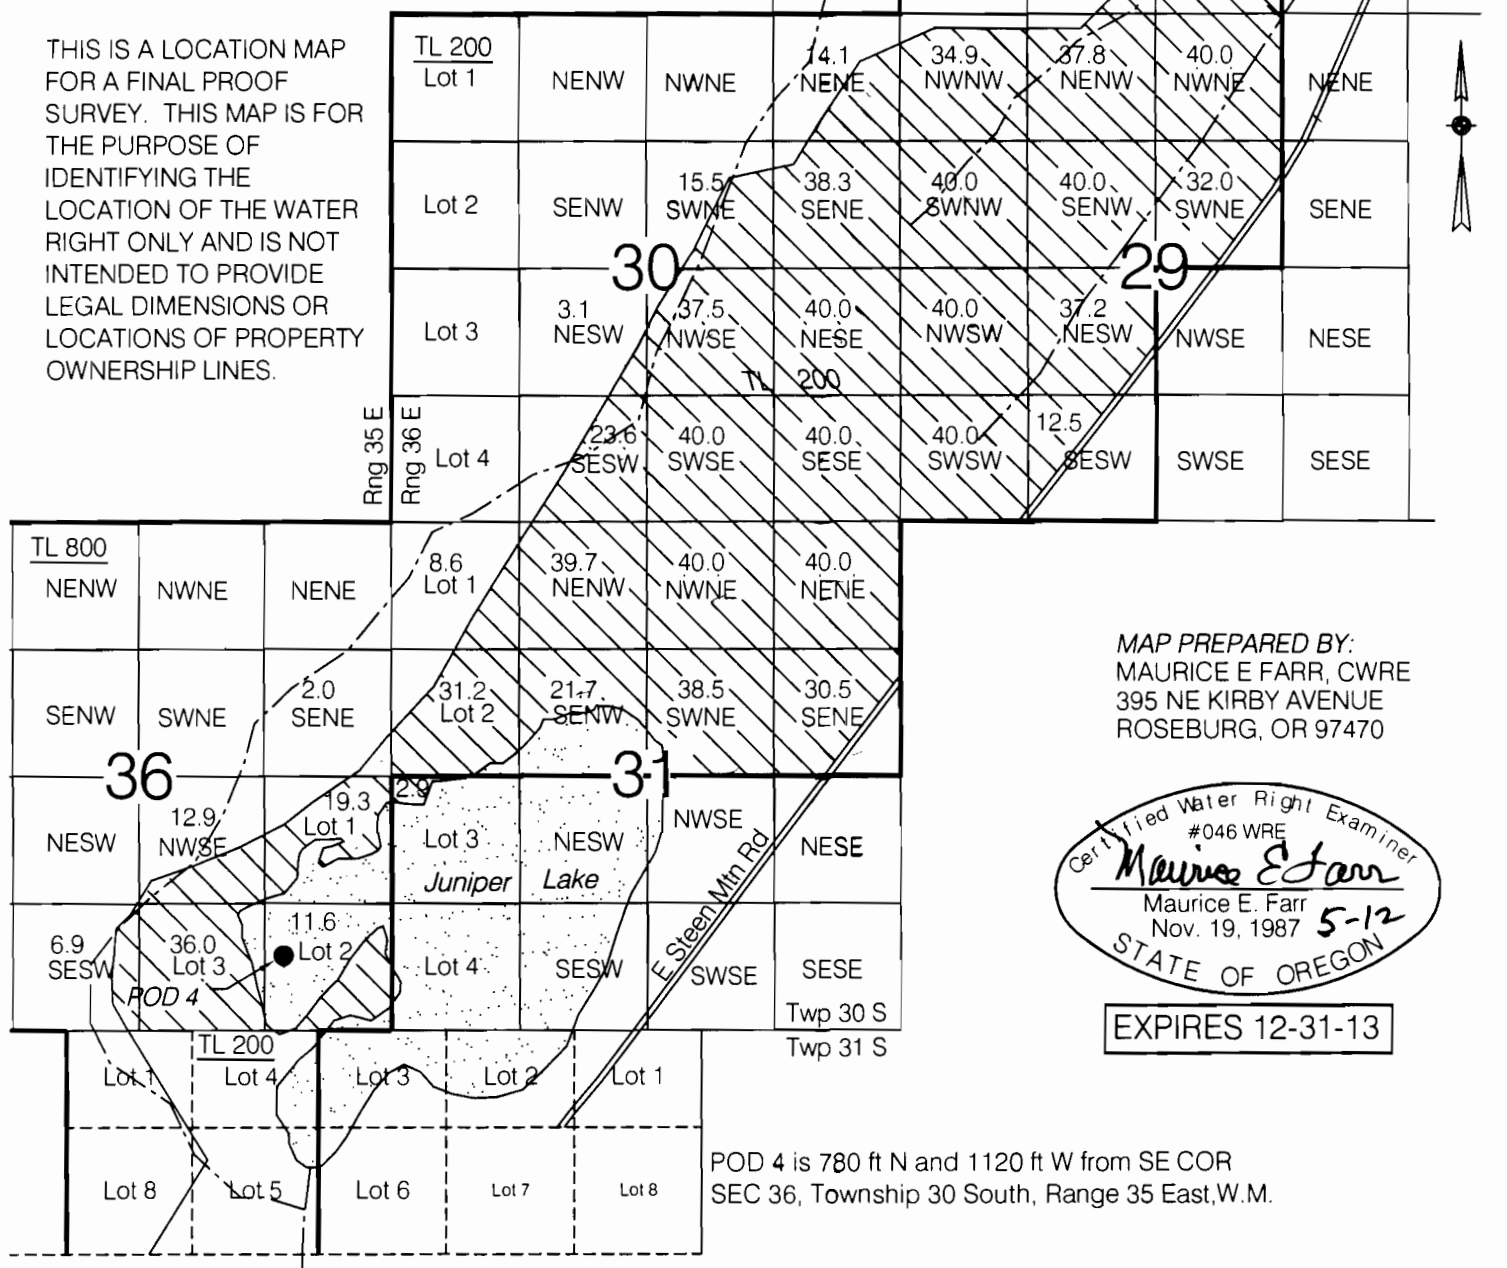

MAP PREPARED BY:
MAURICE E FARR, CWRE
395 NE KIRBY AVENUE
ROSEBURG, OR 97470

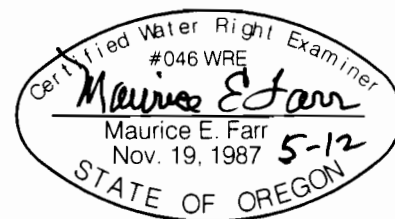

EXPIRES 12-31-13

POD 4 is 780 ft N and 1120 ft W from SE COR
SEC 36, Township 30 South, Range 35 East, W.M.

Corrected Map May 2012

FINAL PROOF SURVEY UNDER

FINAL PROOF SURVEY MAP
T31S, R35E, WM

ARNEY COUNTY
SCALE 1" = 2000'

Map 3 OF 3

Application No. S-80953 Permit No. 53589 MAY 24 2012
IN NAME OF

John R. Atkinson, et al

**WATER RESOURCES DEPT
SALEM, OREGON**


Surveyed August 7, 2011 by M E Farr

THIS IS A LOCATION MAP FOR A FINAL PROOF SURVEY. THIS MAP IS FOR THE PURPOSE OF IDENTIFYING THE LOCATION OF THE WATER RIGHT ONLY AND IS NOT INTENDED TO PROVIDE LEGAL DIMENSIONS OR LOCATIONS OF PROPERTY OWNERSHIP LINES.

MAP PREPARED FOR:

NORTHWEST FARM CREDIT SERVICES, FLCA
JOHN R. ATKINSON & DONNA M. ATKINSON
RONALD D. ATKINSON & BONNIE A. ATKINSON
JOHN R. ATKINSON, Trustee of the
JOHN R. and DONNA M. ATKINSON TRUST
DONNA M. ATKINSON, Trustee of the
JOHN R. and DONNA M. ATKINSON TRUST
2823 NW KLINE STREET
ROSEBURG, OR 97471

POD 5 is 1100 ft N and 150 ft E from SW COR SEC 3
POD 6 is 1250 ft S and 150 ft E from NW COR SEC 10
POD 7 is 2380 ft S and 2450 ft E from NW COR SEC 10
POD 8 is 40 ft N and 2770 ft E from SW COR SEC 3
all in Township 31 South, Range 35 East, W.M.

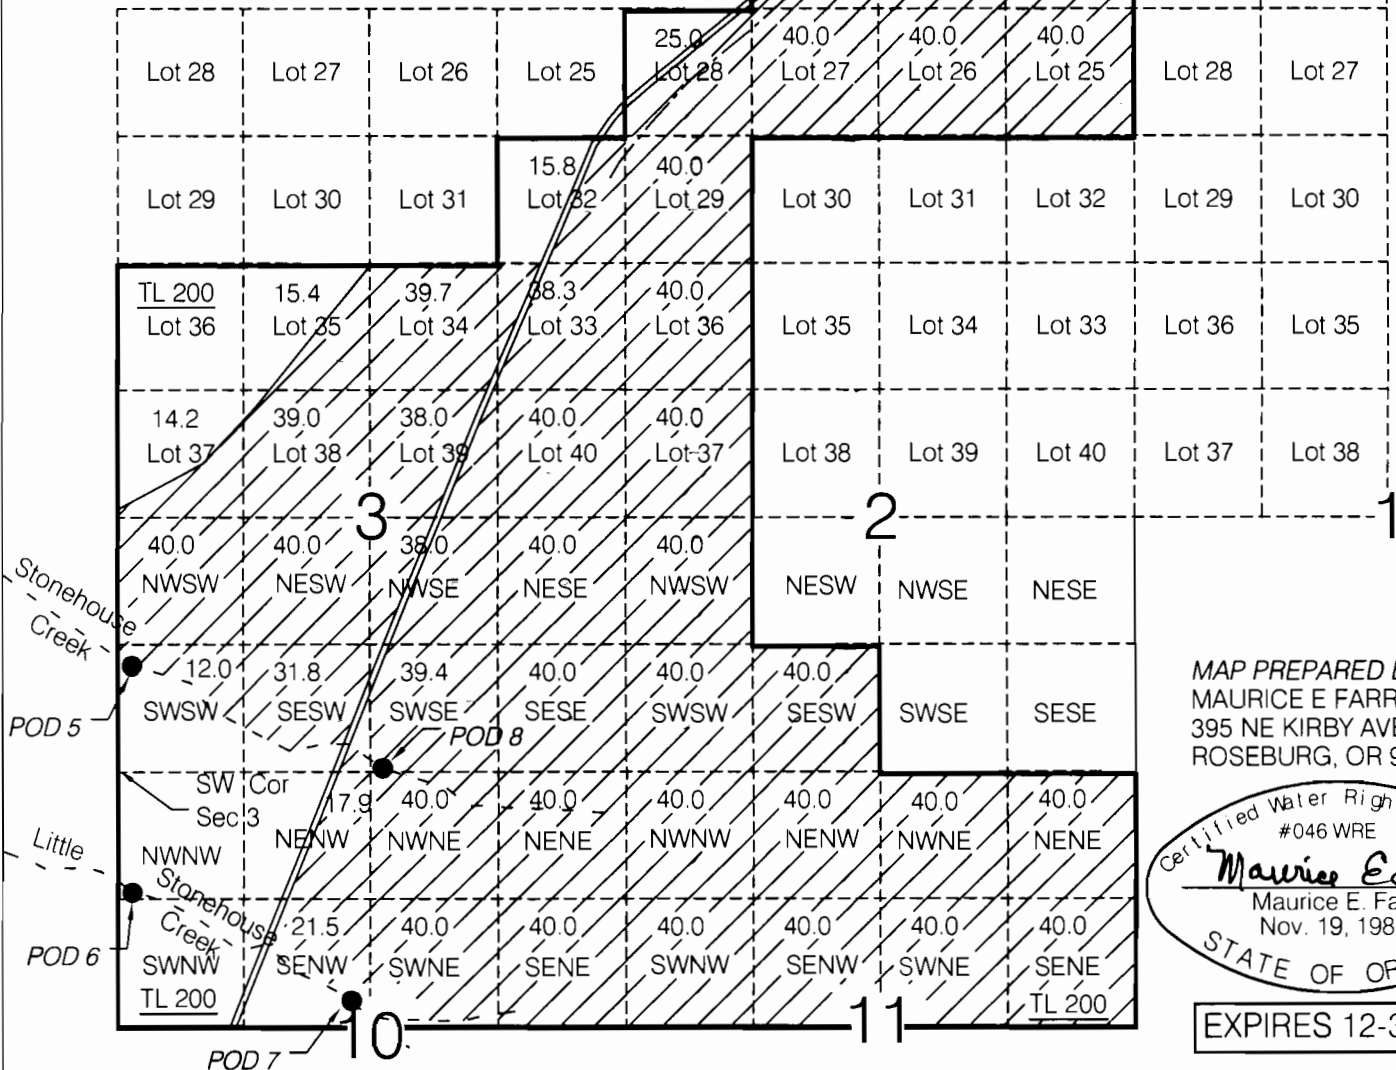

MAP PREPARED BY:
MAURICE E FARR, CWRE
395 NE KIRBY AVENUE
ROSEBURG, OR 97470

Certified Water Right Examiner
#046 WRE
Maurice E Farr
Maurice E. Farr
Nov. 19, 1987 5-12
STATE OF OREGON

EXPIRES 12-31-13