

**RECEIVED**

SEP 21 2011

WATER RESOURCES DEPT  
SALEM, OREGON



Remaining Lands under  
Certificate 84366 in place and  
being watered from the new  
point of diversion as applied for.



Lands irrigated by T-10870  
and having the new point of  
diversion as applied for.

Scale 1" = 1320

August 26, 2011

**FINAL PROOF MAP FOR  
CHANGE OF PLACE OF USE  
AND NEW POINT OF DIVERSION**

FOR


**ANTHONY, PAUL & JOYCE  
PAGLIARULO**

BY

**GREGORY T. BLACKMAN**

126 Ridge Drive

LAGRANDE, OREGON 97850

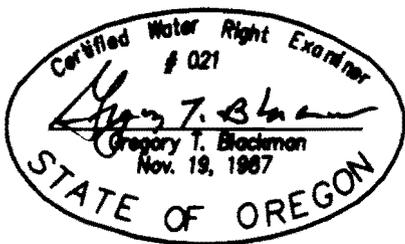

**NOTE:** The preparation of this map was for the purpose of identifying the location of the proposed water right and has no intent to provide dimensions or location of property ownership lines. Location information shown hereon was furnished by the applicant.

Application No. T-10870

Permit Number \_\_\_\_\_