


FINAL PROOF SURVEY MAP IN THE NAME OF JUDITH R. MANICKE


PERMIT 31857

TRANSFER T-8447

SECTIONS 29 & 32, TOWNSHIP 28 SOUTH, RANGE 14 WEST, W.M.

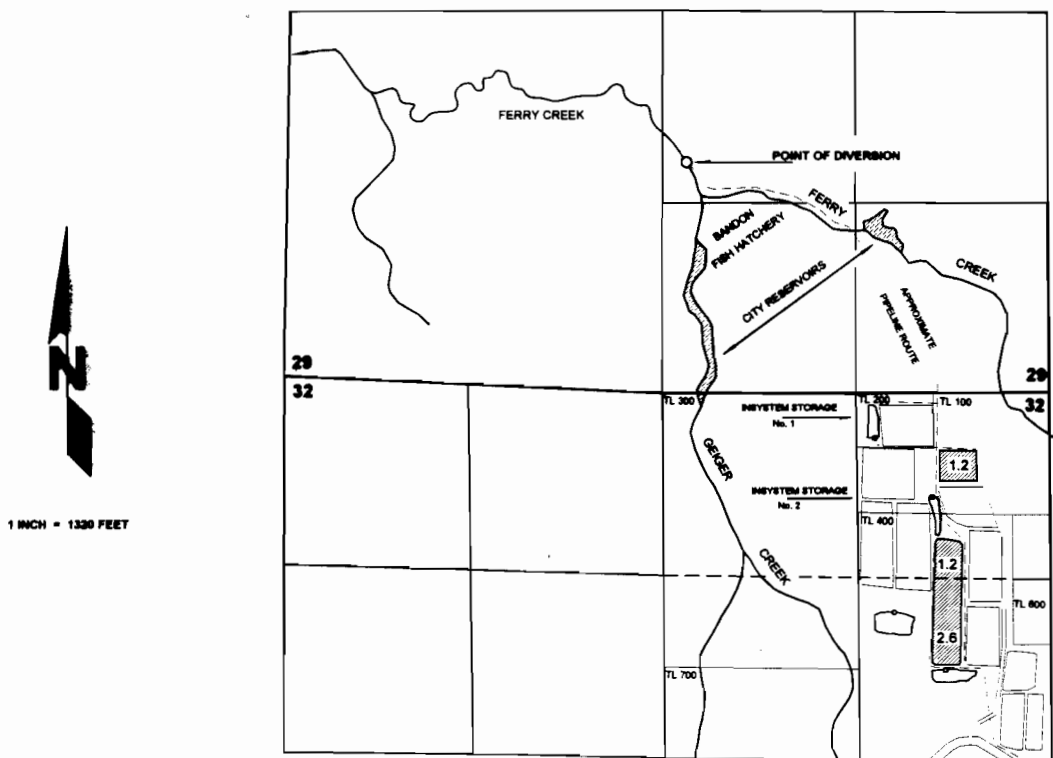

THE POINT OF DIVERSION IS LOCATED 4180 FEET NORTH AND 2480 FEET WEST FROM THE EAST QUARTER CORNER OF SECTION 32; BEING WITHIN THE NW $\frac{1}{4}$ SE $\frac{1}{4}$ OF SECTION 29, TOWNSHIP 28 SOUTH, RANGE 14 WEST, W.M.; COOS COUNTY.

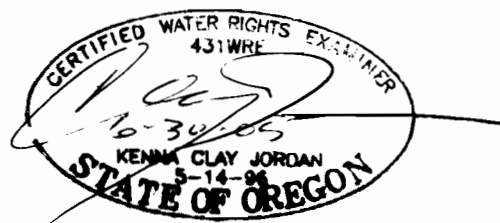

THE PURPOSE OF THIS MAP IS TO IDENTIFY THE LOCATION OF THE WATER RIGHT.
IT IS NOT INTENDED TO PROVIDE INFORMATION RELATIVE TO THE LOCATION OF
PROPERTY OWNERSHIP BOUNDARY LINES.