



T.5S. R.1E. Section 2

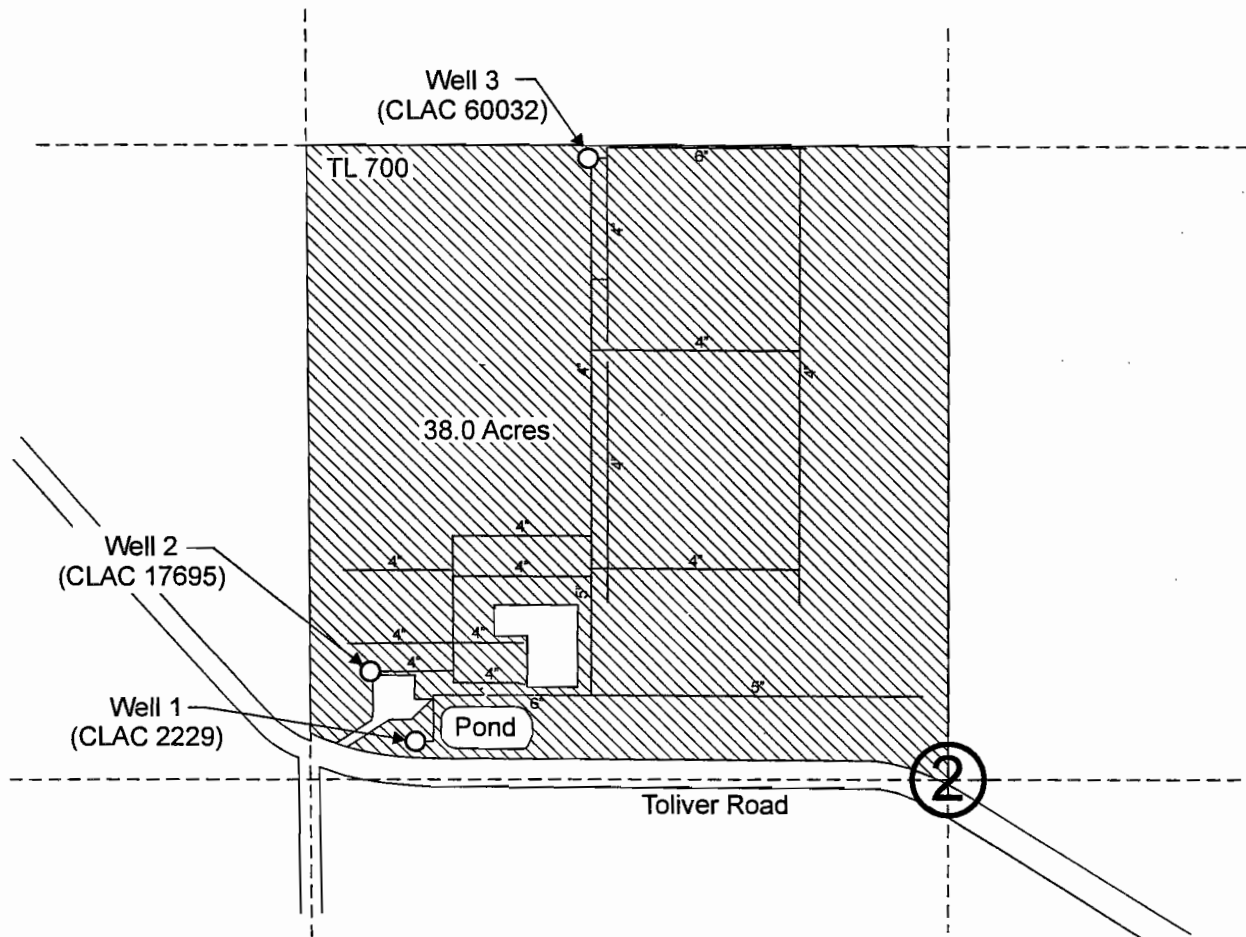

Well 1 (CLAC 2229) is located 80 feet north and 1,110 feet west from the center of Section 2.
 Well 2 (CLAC 17695) is located 230 feet north and 1,200 feet west from the center of Section 2.
 Well 3 (CLAC 60032) is located 1,300 feet north and 750 feet west from the center of Section 2.
 Area (38.0 Acres) irrigated under Transfer 9289.


RECEIVED

WATER RESOURCES DEPT
 SALEM, OREGON

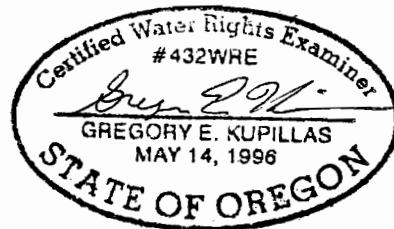

EXPIRATION DATE: 6/30/07

Scale: 1" = 400'

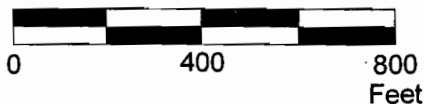

This map was prepared for the purpose of identifying the location of a water right only and is not intended to provide legal dimensions or location of property ownership lines.

Figure 1. Claim of Beneficial Use Map
 Transfer 9289

Pacific Hydro-Geology Inc.

Highland Meadow Nursery
 Tax Lot 5 1E 2 700

9/2006