


RECEIVED

JUN - 2 1998

WATER RESOURCES DEPT.
SALEM, OREGON

Township 4 South, Range 1 East, W.M.

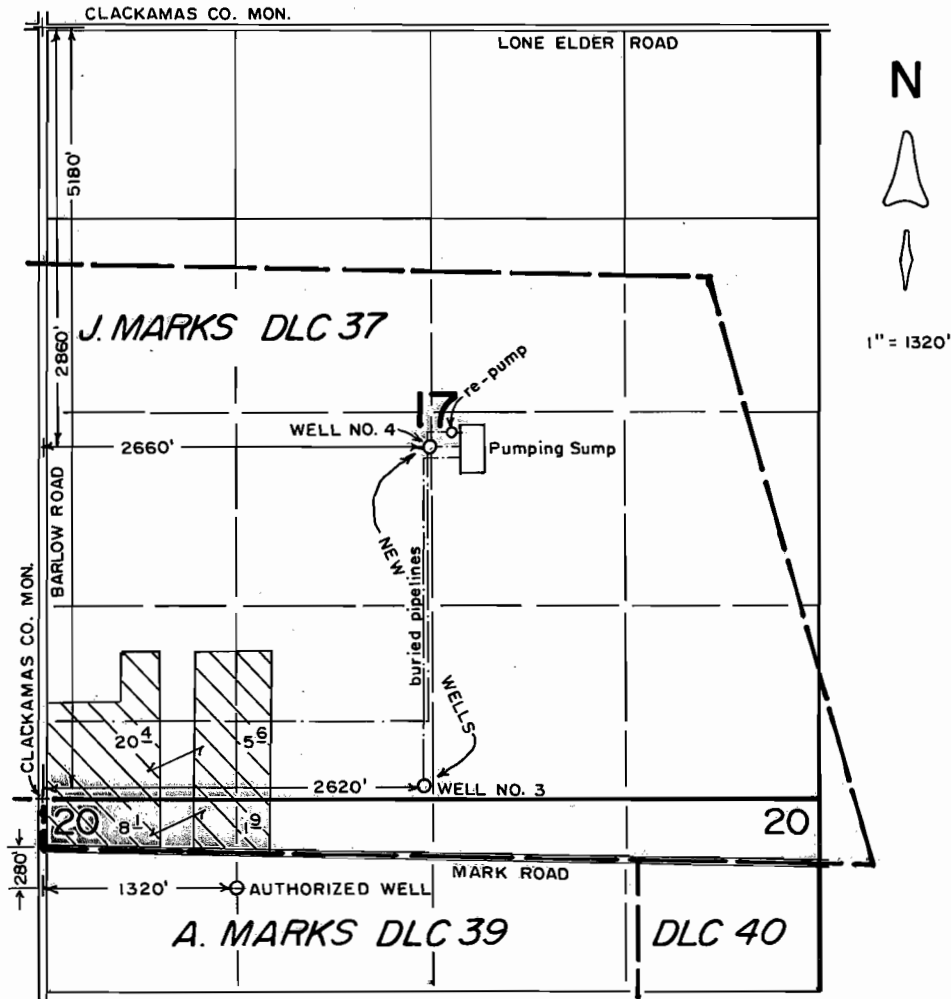

FINAL PROOF SURVEY

under

Transfer No. 7042

in name of

J. FRANK SCHMIDT & SON CO.

Mar. 11, 1998

