



FINAL PROOF SURVEY
 FLOWERREE FARMS, INC.
 CHRISTMAS VALLEY, OREGON
 TRANSFER T-7081

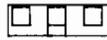

SCALE 1" = 1320'
 0 1320'

 WATER RIGHT UNDER PERMIT G 10160
 PERMIT G - 10160 AND G - 10703
 32 ACRES OF WATER IN USE FROM
 TRANSFER T - 7081

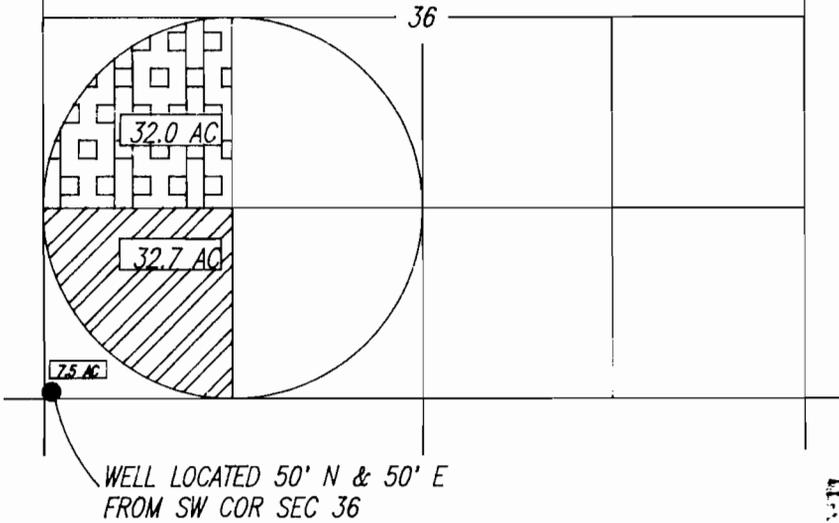

RECEIVED

OCT 25 1999


WATER RESOURCES DEPT.
 SALEM, OREGON



REGENS 6-30-00

I, Joel G. Smith, Certified Water Rights Examiner No. 120, do hereby certify that this map was prepared under my direction. This map has been prepared to show an area of water right use and does not represent a boundary survey or show areas of land ownership.

© COPYRIGHT 1999, TERRASCOPE, INC.

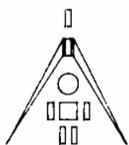

TERRASCOPE, INC.
 405 SW Eighth St
 Redmond, OR 97756
 Tel: (541) 548-7852
 Fax: (541) 548-7854

FINAL PROOF SURVEY
 SW 1/4, SEC. 36,
 T 26 S, R 18 E
 LAKE COUNTY, OR

DRAWING NO: F829-2
 DATE: 10/18/99
 DRAWN BY: MEH
 CHECKED BY: JGS
 PROJECT NO: F117-829