

Claim of Beneficial Use

Transfer No. 7021


Permit No. 1150

Section 30, T20S, R47E, WM - Tax Lot No. 20 47 1100




Scale: 1" = 1320'

For: Ronald & Marie Kuenzli
PO Box 284
Star, ID 83669

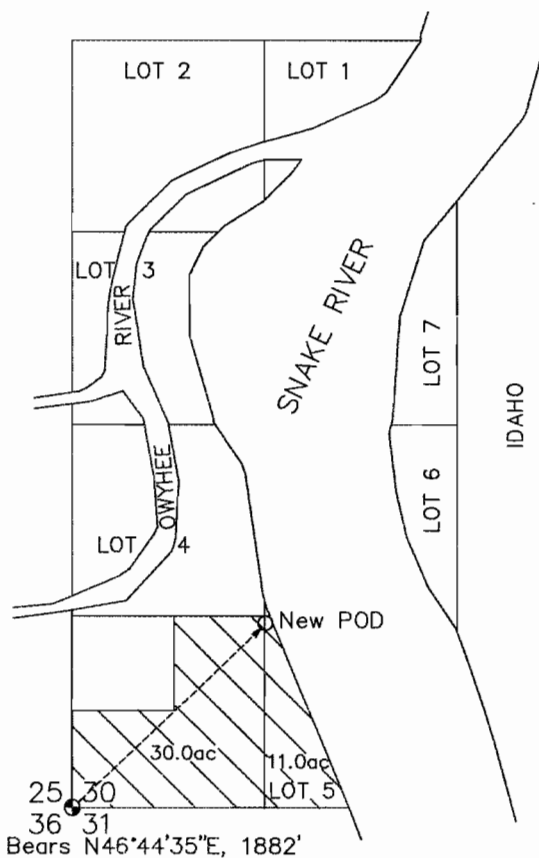

POD Bears N46°44'35"E, 1882'

This map is for the purpose of identifying the location of the water right only and has no intent to provide dimensions or location of property ownership lines.

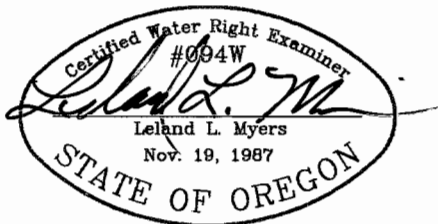

RECEIVED

SEP 29 2000

WATER RESOURCES DEPT.
SALEM, OREGON