


RECEIVED

JUN 23 1999

WATER RESOURCES DEPT.  
SALEM, OREGON

T. 1 S. R. 2 W. W.M.

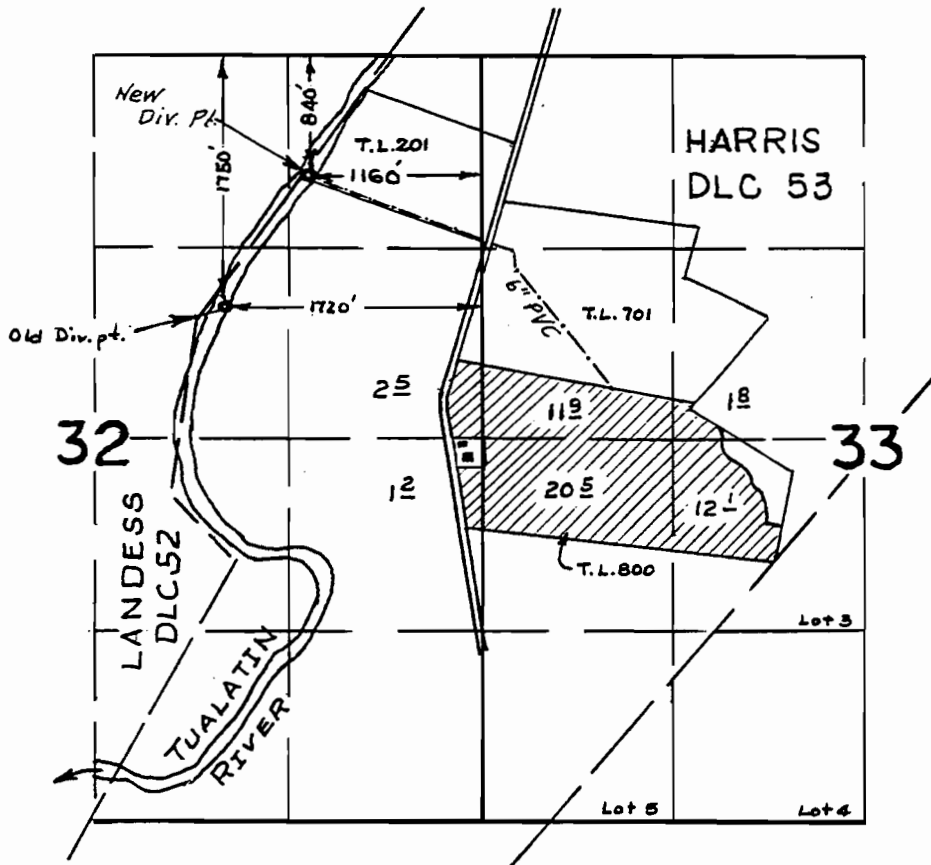

Scale  
4" = 1 Mi.

**FINAL PROOF SURVEY  
UNDER**


TRANSFER NO. T-7445

~~Application No.~~ ~~Permit No.~~

IN NAME OF

MYRON & LOIS BISH

Surveyed June 16, 1999, by ...

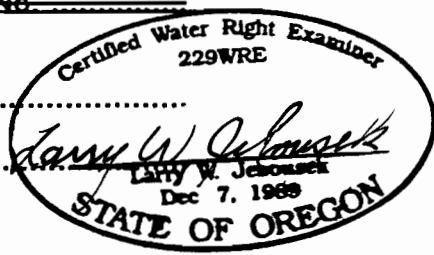

THIS MAP WAS PREPARED FOR THE PURPOSE OF IDENTIFYING THE LOCATION OF A WATER RIGHT ONLY AND IS NOT INTENDED TO PROVIDE LEGAL DIMENSIONS OR LOCATION OF PROPERTY OWNERSHIP LINES.

Inspection