

FINAL PROOF MAP T-9229
 GOVT. LOTS 2, 3 AND
 D.L.C. NO. 37 AND 38
 T. 38 S., R. 8 W. SEC. 33, W.M.
 JOSEPHINE COUNTY, OREGON
 FOR
 THOMAS AND NANCY ACORD
 P.O. BOX 3280
 KERBY, OR 97531

T. 38 S., R. 8 W.


N.E. Cor. DLC No. 37

GOVT. LOT 2

DLC No. 37

S.E. Cor. DLC No. 37
 N.E. Cor. DLC No. 38

2.14 Ac.

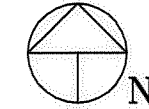

Scale: 1"=400'
 Date: July 10, 2007

LEGEND

- Found Survey Monument
- Denotes Building
- === Denotes Driveway
- - - Denotes Mainline Pipe
- Ⓜ Denotes Flow Meter
- ▨ Denotes Area Under Transfer T-9229, Special Order Vol. 70, Pg. 606-608

Note: DLC and Govt. Lot Lines projected from GLO Record.

This map was prepared for the purpose of identifying the location of a water right only and is not intended to provide legal dimensions or location of property ownership.

Illinois River Source:
 East Fork Illinois River

Illinois River

Tax Lot 900
 38 8W 33

6.26 Ac.

4.67 Ac.

DLC No. 38

33

GOVT. LOT 3

Tax Lot 1001
 38 8W 33

Mainline Pipe

Redwood Hwy.
 No. 199

S.E. Cor. DLC No. 38

GOVT. LOT 4

Point of Diversion No.1
 Situated 1420' North and
 720' West from the South
 One-Quarter Corner, Sec. 33.
 Fish Screen at Intake


GOVT. LOT 5

South 1/4 Cor.

RECEIVED

OCT 15 2007

WATER RESOURCES DEPT
 SALEM OREGON

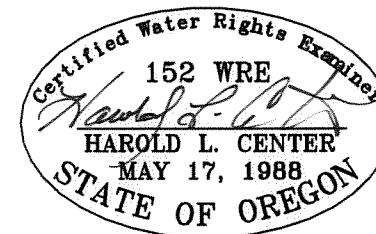

HAROLD L. CENTER
 2604 David Lane
 Medford, OR. 97504
 Phone 541-535-6108
 Oregon Certificate No. 152
 Certificate Renewal Date: 12/31/2007

COBU MAP # 0291

0291