


TOWNSHIP 16 SOUTH, RANGE 4 WEST, W.M.

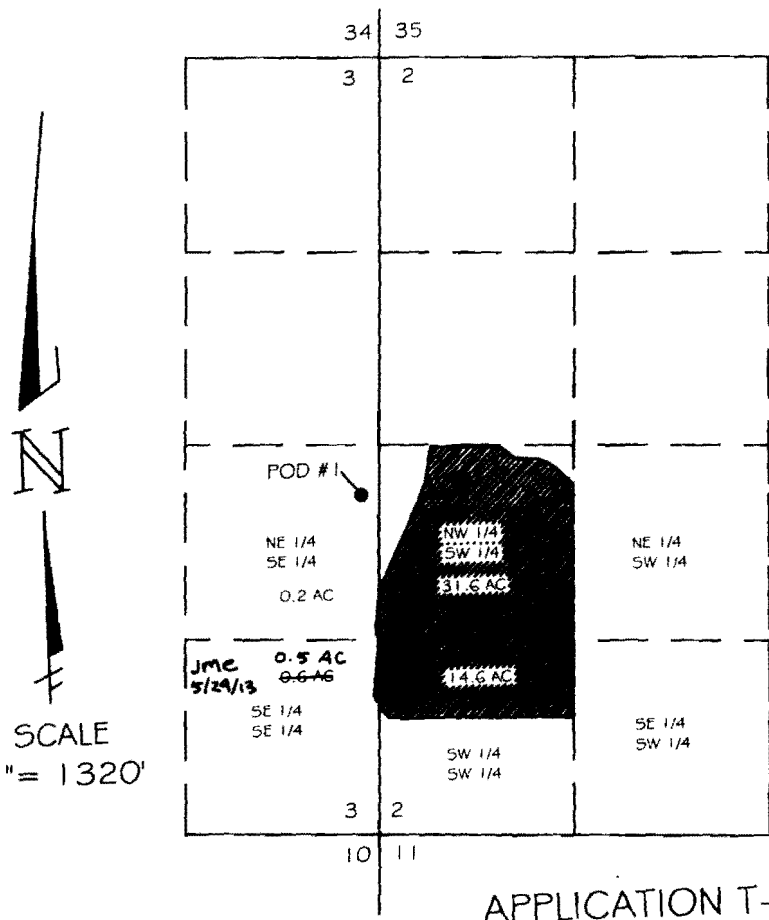

JUN 07 2012


APPLICATION T-6918

POINT OF DIVERSION LOCATION:
3000.00 FEET SOUTH & 120.00
FEET WEST FROM NORTHEAST
CORNER OF SECTION 3

FINAL PROOF SURVEY
POINT OF DIVERSION TRANSFER
FOR

GARY & JANICE KROFF
30659 WYATT DRIVE
HARRISBURG, OREGON 97446
541-995-8383

BY
H. TIMOTHY FASSBENDER, PLS, CWRE
2896 SARAH LANE
EUGENE, OREGON 97408
541-485-3136
MAY 29, 2012

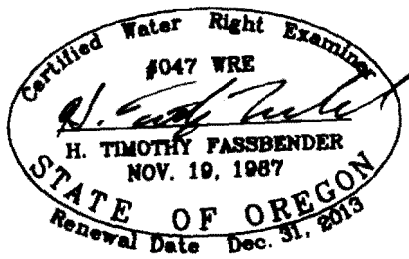

NOTE:
THIS MAP IS NOT INTENDED TO PROVIDE
LEGAL DIMENSIONS OR LOCATIONS OF
PROPERTY OWNERSHIP LINES.