


T.36S.,R.1E.,W.M.

RECEIVED

Water Right  



SCALE 1" = 1320'

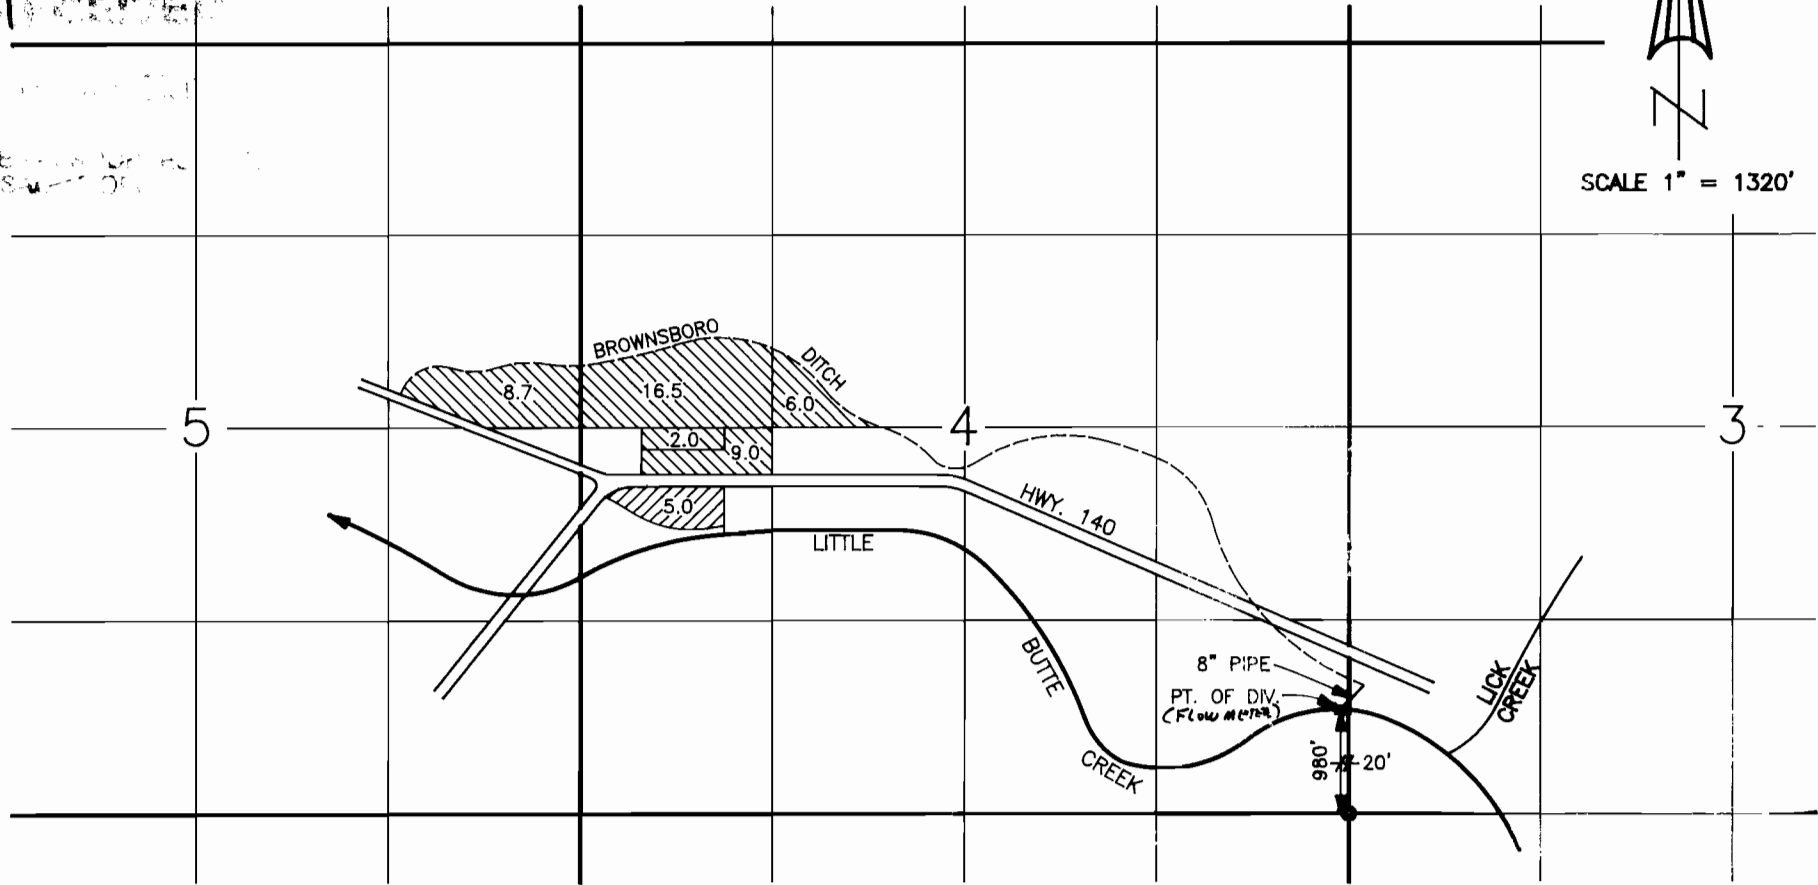


FINAL PROOF MAP

APPLICATION No. T-7998

IN THE NAME OF  
GERALD HANSEN

NOTE: MAP PREPARED FOR  
WATER RIGHT PURPOSES ONLY,  
NOT FOR PROPERTY BOUNDARY  
LOCATIONS.

 = CERT. No. 46187  
42.2 Ac.

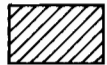 = CERT. No. 17188  
5.0 Ac.

MAP PREPARED SEPTEMBER 12, 2000 BY GARY D. KAISER

