
## T.4S. R.1W., W.M.

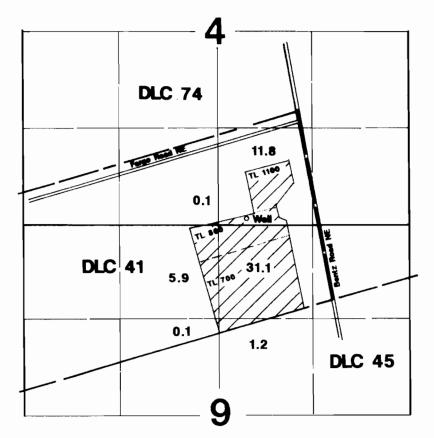



Well is located 1185'N & 1152'W from the SE corner of DLC 41.

## **Final Proof Survey**

Transfer #: T-8408

In Name Of

## John & Maxine Singer

Surveyed on September 6, 2003 by JM Schuette

This Map Was Prepared For The Purpose Of Identifying The Location Of A Water Right Only And Is Not Intended To Provide Legal Dimensions Or Location Of Property Ownership Lines.

