

Claim of Beneficial Use Map
Section 26, T.27S. R.16E., W.M.

Lake County, Oregon

Tax Lots 900 & 1100

T-8409

RECEIVED


SEP 25 2001



SCALE

1" = 1320'

Authorized P.O.A. is Beck Well, location as per
Permit #G-2488 is 1290' North & 1910' East
from the SW corner Section 26

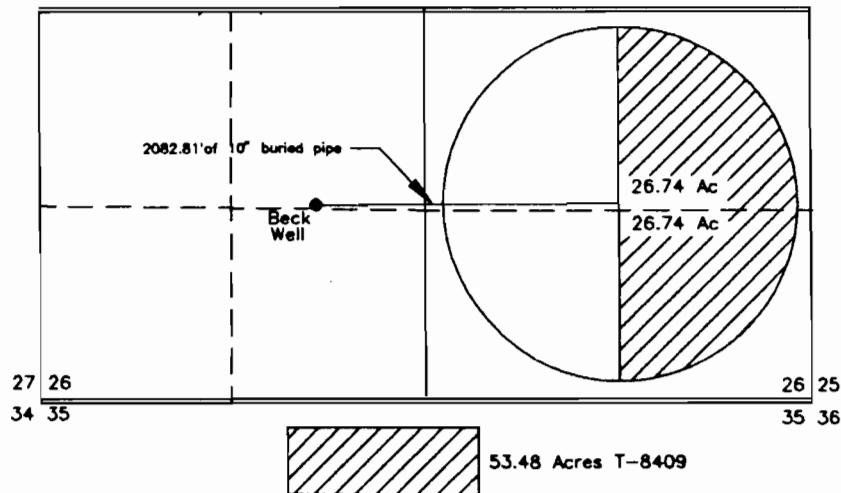

Surveyed for: Mark Bedinger
Surveyed by: Sundet & Associates
P.O. Box 1228
Lakeview, OR 97630
(541)947-3293

Drawing #14301
09/2001

This map is for the purpose of identifying the location of the
water right only and is not intended to provide legal dimensions
of location of property ownership lines.

