


CLAIM OF BENEFICIAL USE TRANSFER 10571

TOWNSHIP 33 SOUTH RANGE 2 EAST, W.M.
JACKSON COUNTY OREGON

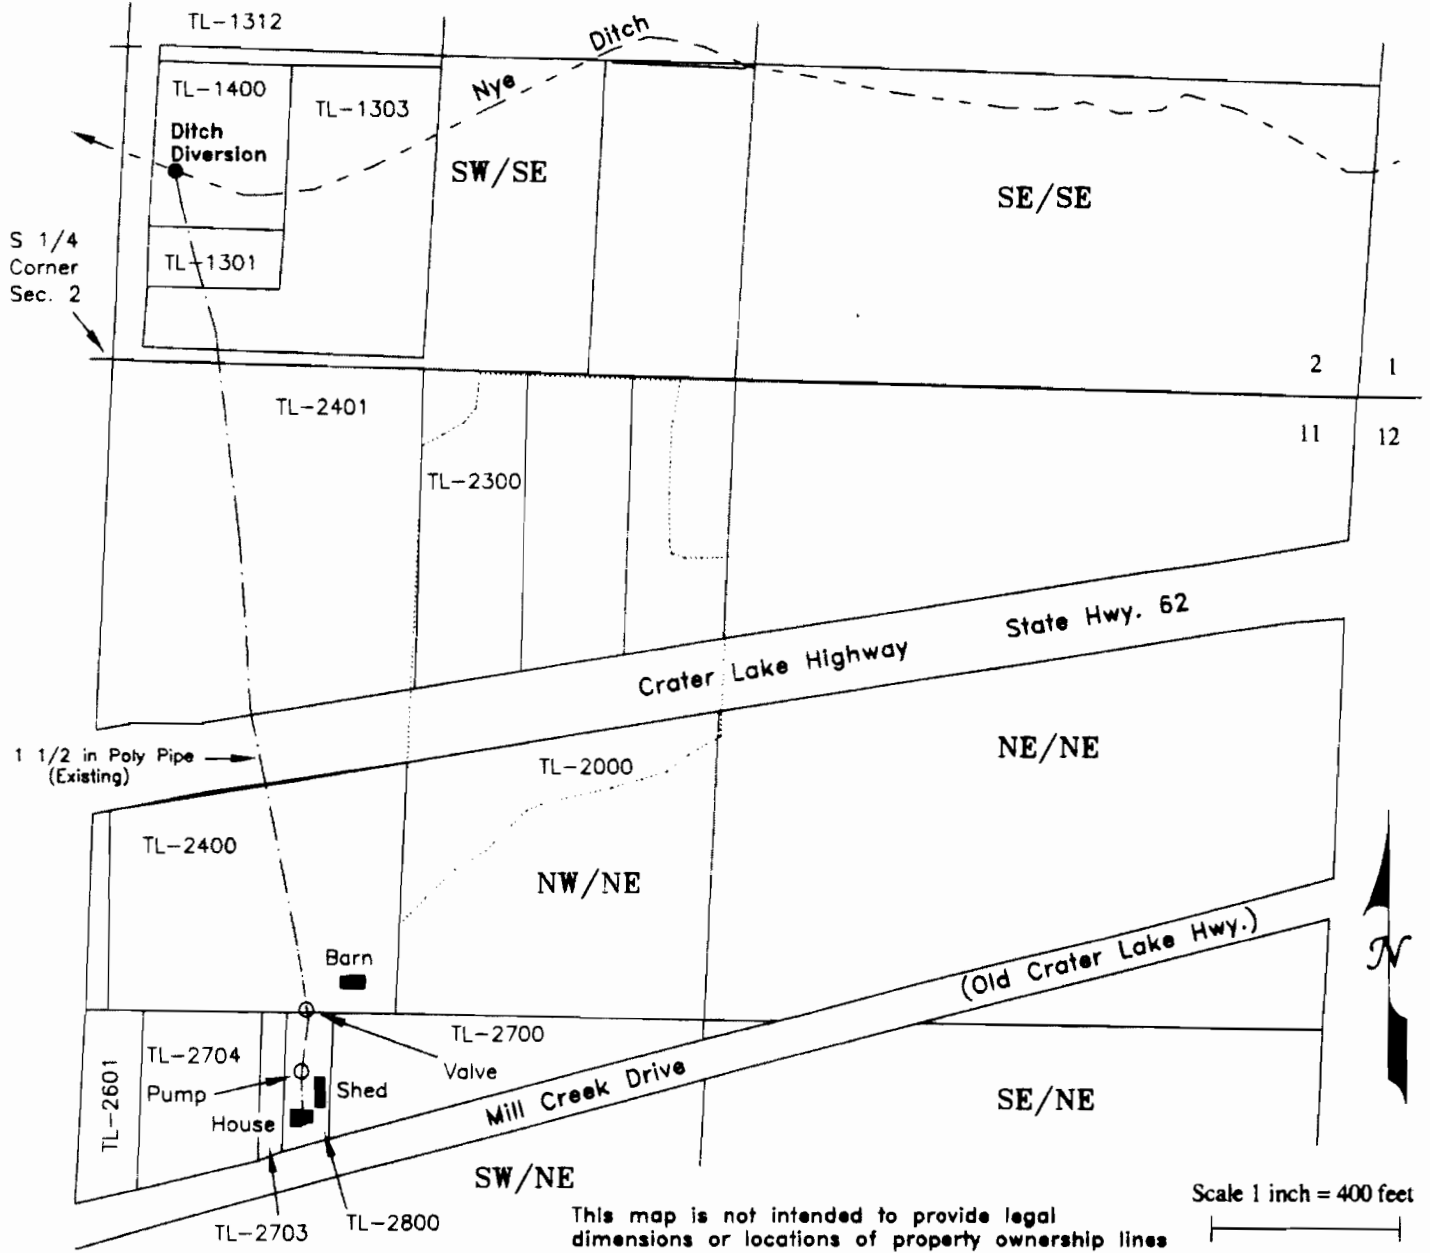


This map is not intended to provide legal dimensions or locations of property ownership lines

- Point of Diversion - Mill Creek - NW/SE, Section 28, T.32S, R.3E., W.M. (Not Changed)
- Diversion from Nye Ditch - SW/SE, Section 2, T.33S, R.2E., W.M.
400 ft. North & 110 ft. East from the S1/4 Corner Section 2

TYPE OF USE - DOMESTIC

CLAIM IN THE NAME OF:

Mary Lou King
1700 Branta Road
Juneau, AK 99801

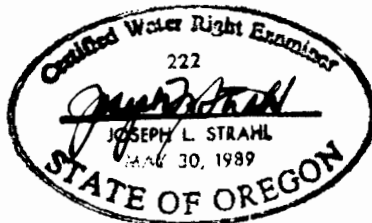

PXX Public Works Management, Inc.
80 N 4TH ST. CENTRAL POINT, OR 97502
(541) 865-5233

Drawn
10/27/2010 n.e.d.

