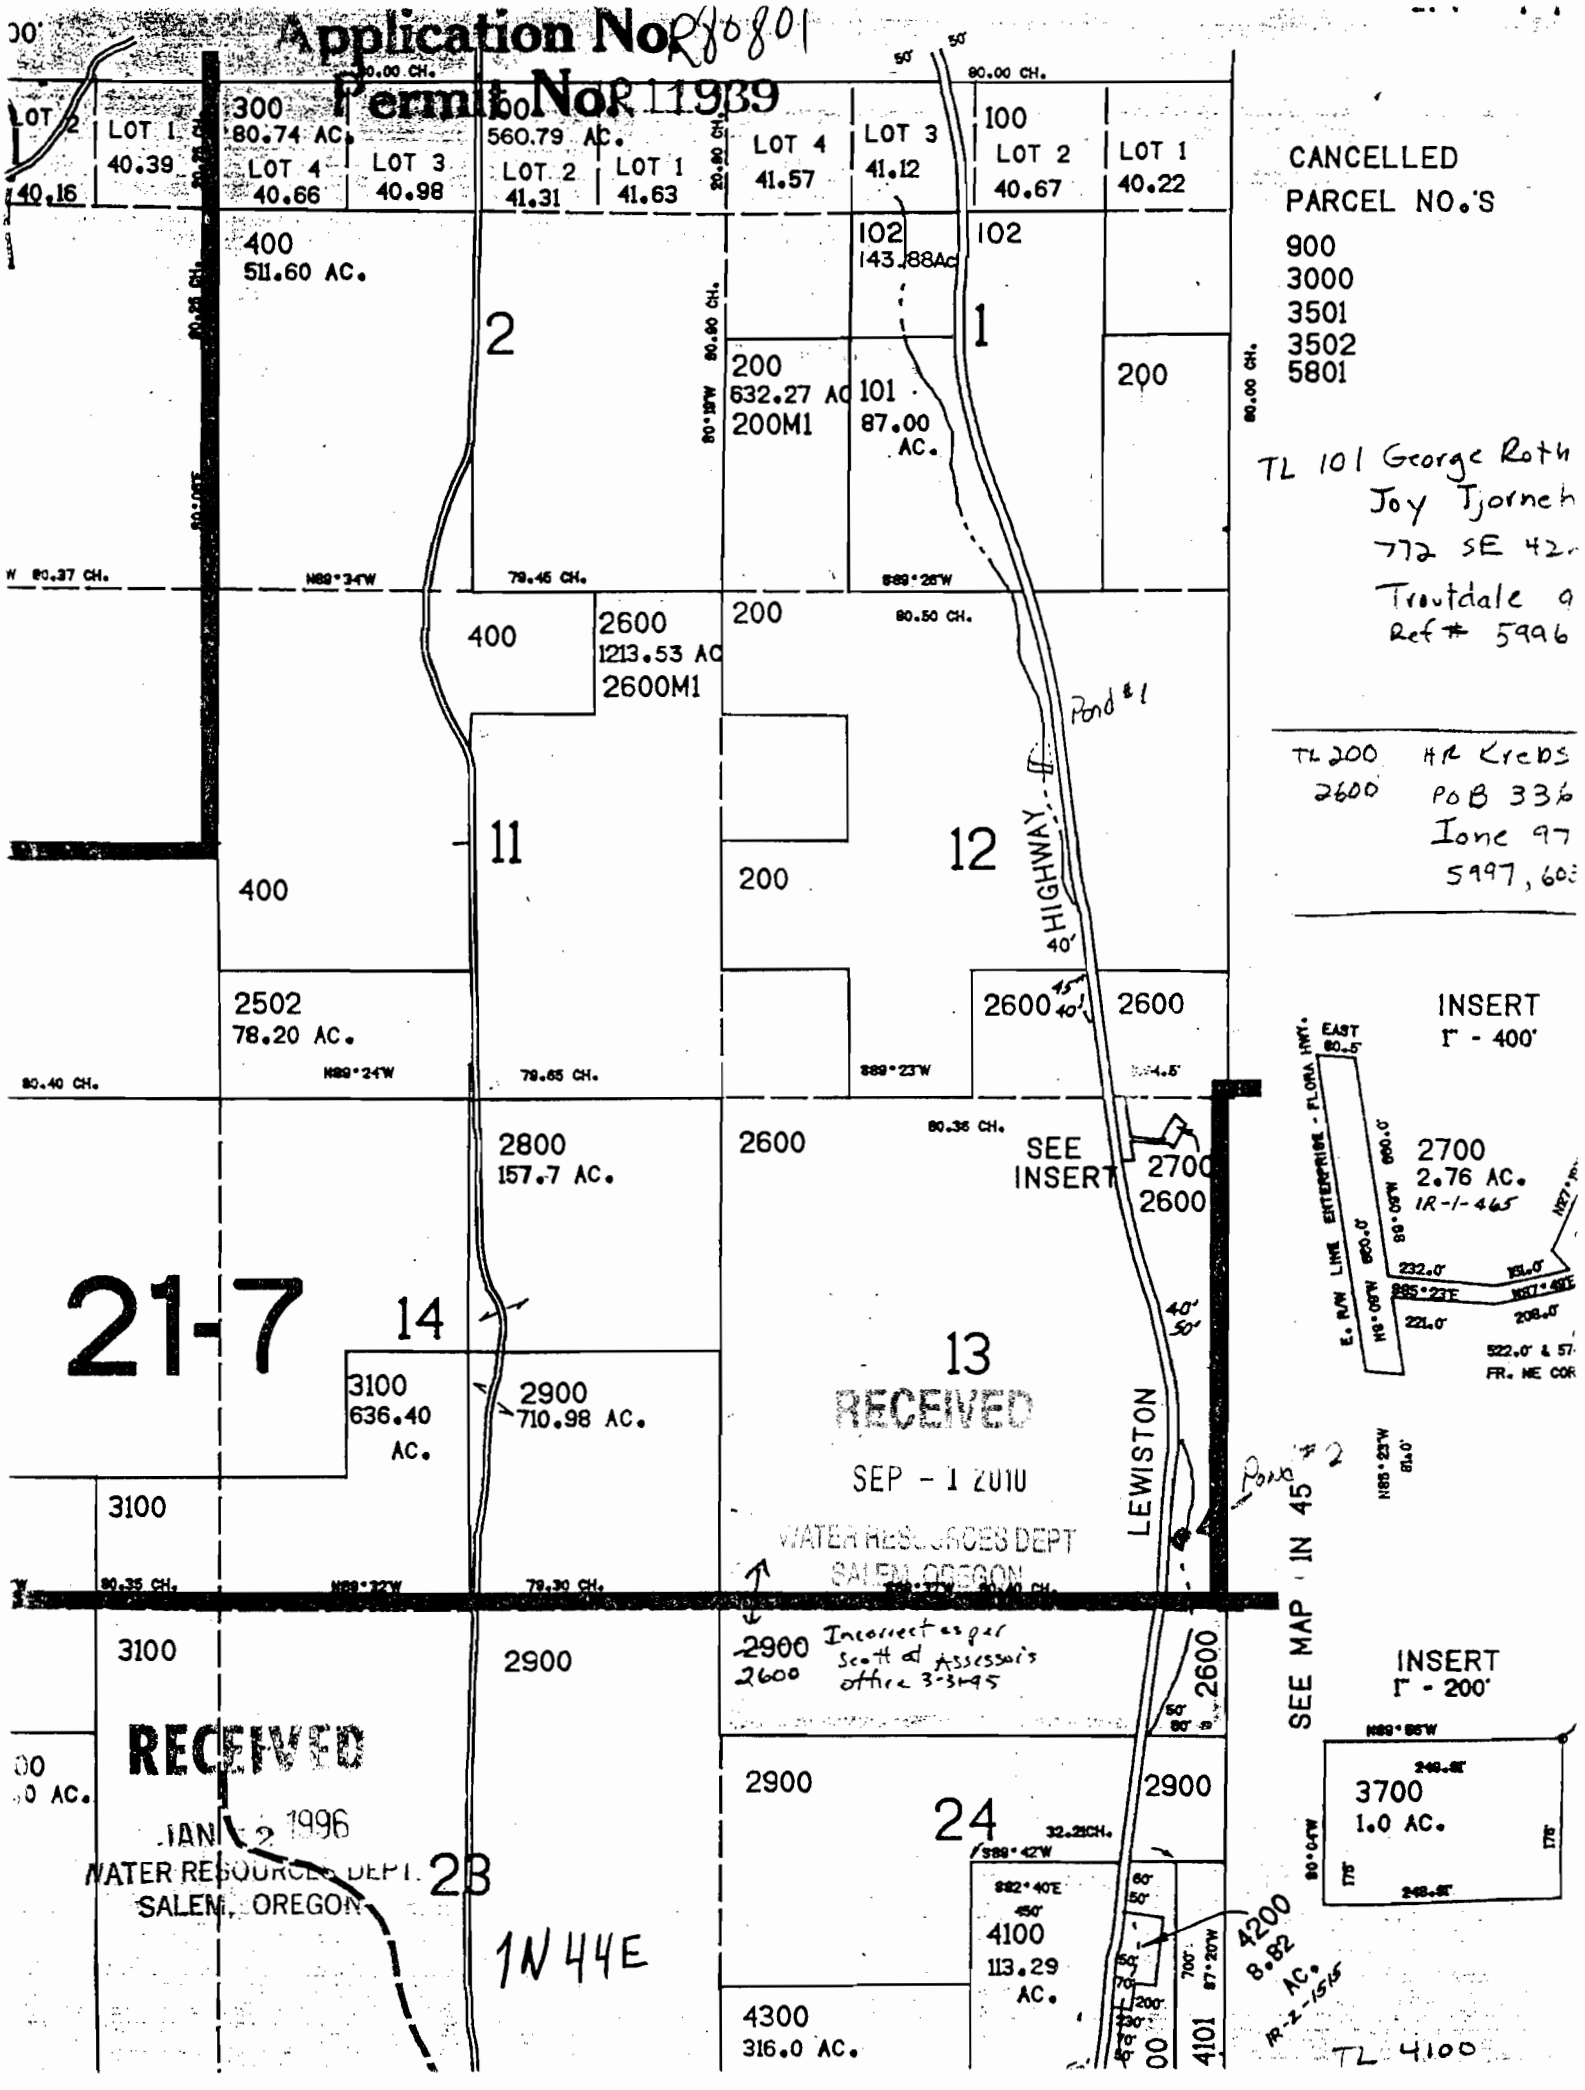
Application No. R80801
Permit No. 11939
CANCELLED
PARCEL NO.'S
900
3000
3501
3502
5801
TL 101 George Roth
Joy Tjorneh
772 SE 42
Troutdale 9
Ref # 5996
TL 200 HR Krebs
2600 PoB 336
Ione 97
5997, 60
HIGHWAY
Pond #1
Pond #2
LEWISTON
SEE INSERT
SEE MAP 1N 45
INSERT
1" - 400'
INSERT
1" - 200'
E. R/W LINE ENTERPRISE - FLORA HWY.
21-7
1N 44E
RECEIVED
SEP - 1 2010
WATER RESOURCES DEPT
SALEM, OREGON
RECEIVED
JAN 12 1996
WATER RESOURCES DEPT.
SALEM, OREGON
Incorrect as per Scott at Assessor's office 3-3-95
TL 4100