



T. 9S., R. 40E., W.M.

New P.O.D. Located in the NW¼SW¼ of Section 21, 180' S. and 110' E. from the W¼ Corner Section 21.



Scale: 1" = 1320'

This map is for the purpose of identifying the water right location only and is not intended to provide legal dimensions or location of property ownership lines.

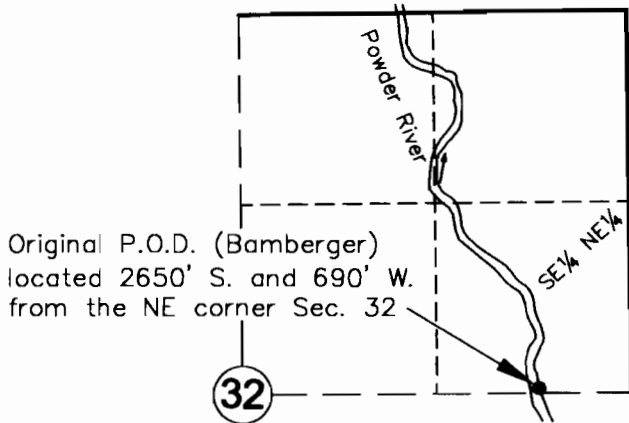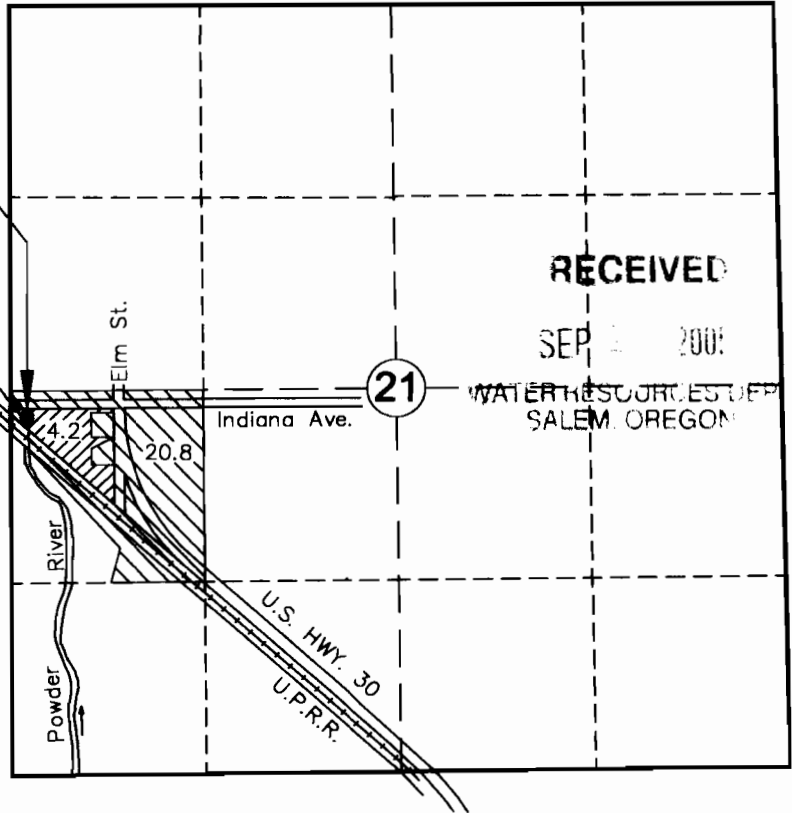

Original P.O.D. (Bamberger) located 2650' S. and 690' W. from the NE corner Sec. 32

FINAL PROOF SURVEY
Change in Point of Diversion
In Name of Ronald Paul
Reference T-9589
Site Survey July 14, 2005
by Hanley Engineering, Inc.

LEGEND

- Lands irrigated from New P.O.D.
- Remaining Rights from Bamberger P.O.D. (Cert. #4391)

