

T6N, R35E, WM  
Section 26  
Umatilla County



1 inch = 400 feet

WINESAP ROAD

West Branch  
Crockett Creek

10-inch

10-inch

10-inch

10-inch

8-inch

C-12524  
1887  
10.00

C-12525  
1908  
10.00

OLD M-F HWY

26

Storage  
Bulge 2

W/4 Corner

POD 2

Storage  
Bulge 1

POD 1

APPLETON ROAD

~~1900~~  
C-54121  
~~1000~~  
3.39

C-54120  
1903  
5.50

C-54121  
1900  
2.00  
1900

8-inch

6-inch

4-inch

6-inch

8-inch

6-inch


8-inch

POD 3

6-inch

West Ford Branch  
Little WW River

POD 4

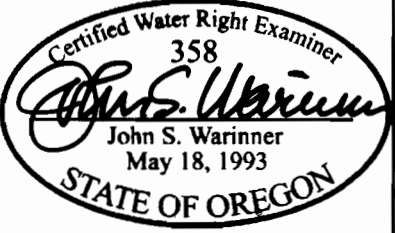

**FOUNTAINHEAD**  
1860 Blue Creek Road  
Walla Walla, WA 99362  
509.529.2646 phone

*The purpose of this map is to identify the location of a water right. It is not intended to provide information regarding the location of property ownership boundary lines.*

**COBU MAP  
Transfer 9163**

in the name of  
**DAVIS ORCHARDS**

Revised 01 APR 2008

- Authorized POD**
- POD 1 weir located 90 ft N and 1620 ft E from W/4 Corner S26 (Certs 12524 and 12525).
  - POD 2 weir located 60 ft N and 650 ft E from W/4 Corner S26 (Certs 12524 and 12525).
  - POD 3 weir located 1365 ft N and 985 ft E from SW Corner S26 (Certs 54120 and 54121).
  - POD 4 weir located 120 ft N and 1340 ft E from SW Corner S26 (Certs 54120 and 54121).

27 26

34 35 SUNNYSIDE ROAD

Revised by WRD 6/4/2013 JL