

T6N, R35E, WM
Section 26
Umatilla County



1 inch = 400 feet

WINESAP ROAD

West Branch
Crockett Creek

10-inch

10-inch

10-inch

10-inch

C-12524
1887

10.00

C-12525
1908

10.00

Storage
Bulge 2

W/4 Corner

POD 2

8-inch

Storage
Bulge 1

OLD M-F HWY

26

APPLETON ROAD

POD 1

C-54120
1903

5.50

C-54121
1900

3.39

C-54121
1900

2.00

1900

8-inch

6-inch

4-inch

6-inch

8-inch

6-inch


6-inch

POD 3

6-inch

West Ford Branch
Little WW River

POD 4

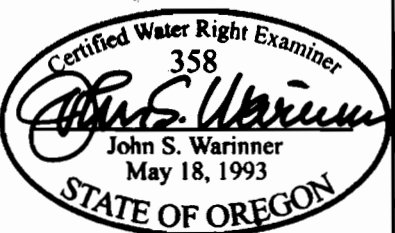

FOUNTAINHEAD
1860 Blue Creek Road
Walla Walla, WA 99362
509.529.2646 phone

The purpose of this map is to identify the location of a water right. It is not intended to provide information regarding the location of property ownership boundary lines.

**COBU MAP
Transfer 9163**

in the name of
DAVIS ORCHARDS

Revised 01 APR 2008

Authorized POD

POD 1 weir located 90 ft N and 1620 ft E from W/4 Corner S26 (Certs 12524 and 12525).

POD 2 weir located 60 ft N and 650 ft E from W/4 Corner S26 (Certs 12524 and 12525).

POD 3 weir located 1365 ft N and 985 ft E from SW Corner S26 (Certs 54120 and 54121).

POD 4 weir located 120 ft N and 1340 ft E from SW Corner S26 (Certs 54120 and 54121).

27 26

34 35 SUNNYSIDE ROAD

Revised by WRD 6/4/2013 JL