


T.35S.,R.3E.,W.M.

Jackson County, Oregon

Tax Lot No. 353E-1500

ROGUE RIVER BASIN

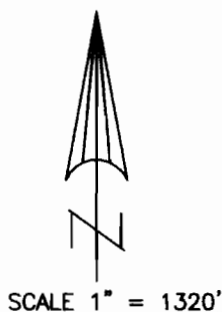


SCALE 1" = 1320'

RECEIVED



NOV 02 2011

WATER RESOURCES DEPT
SALEM, OREGON

PLACE OF USE FROM
PERMIT NO. 3580
CERT NOT. 4934
0.30 CFS

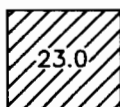

PLACE OF USE FROM
PERMIT NO. 6033
CERT NO. 8492
0.36 CFS

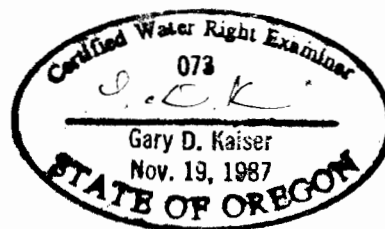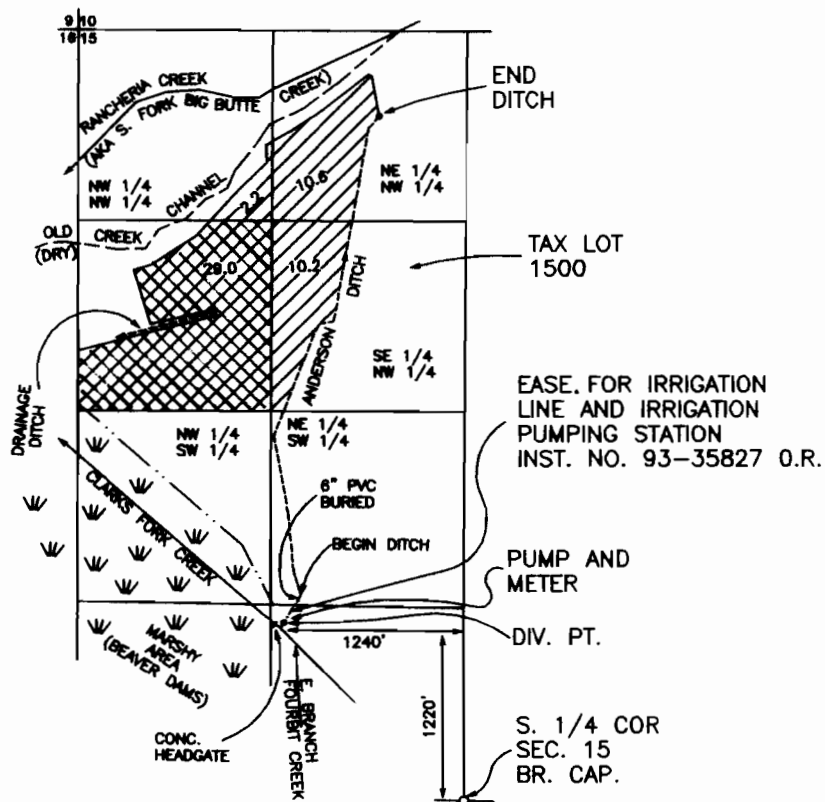

BENEFICIAL USE MAP

NEW MAP SUPERSEDING FINAL
PROOF MAP FOR T-6637 IN THE
NAME OF CITY OF MEDFORD WATER
COMMISSION DATED SEPTEMBER 26, 1994

NOTE: MAP PREPARED FOR
WATER RIGHT PURPOSES ONLY,
NOT FOR PROPERTY BOUNDARY
LOCATIONS.

TRANSFER NO. T-6637
IN THE NAME OF
RON ANDERSON
280 WORTHINGTON ROAD
EAGLE POINT, OR. 97524

MAP PREPARED OCTOBER 14,
2011 BY GARY D. KAISER